

BLACKBURN CREEK CDD

STORMWATER SYSTEM INSPECTION PHASE 3

Prepared for:
Blackburn Creek CDD

Prepared by:
Brletic Dvorak Inc.
436 4th Ave. S., Unit 4
St. Petersburg, FL 33701

March 2025

Contents

- 1.0 SUMMARY
- 2.0 EXISITING SITE CONDITIONS
- 3.0 RECOMMENDATIONS

Appendices

APPENDIX A – MARKED PLAN SETS DOCUMENTS FOR MAINTENANCE WORK



1.0 - SUMMARY:

The Blackburn Creek CDD requested that BDI inspect the stormwater conveyance system in Phase 3 in the Grand Palms Community in preparation for stormwater conveyance system maintenance work for 2025. This includes inlets, pipes, outlets, control structures and swales to determine if the system is operating at full capacity, identify problems or issues (if any), and provide recommendations as needed to restore the functionality of the drainage system.

2.0 – EXISTING SITE CONDITIONS:

In March 2025 BDI completed a visual inspections of the Phase 3 drainage system as well as conducted a review of SWFWMD ERP permits and permitted plan sets. While our site inspection did not include a full inspections of the entire length of the storm sewer pipes, we were able to inspect inlets, manholes and end sections to determine if there was any accumulation of sand, silt or debris or anything else that may cause blockage within the system.

The findings from the inspection are presented below:

1. Stormwater curb inlets were found to be in good condition. Man hole covers were pulled to complete a visual inspection inside each structure. No significant signs of sediment or debris were observed.
2. Stormwater pipe end section were found to be in good condition. The MES/FES structures operate in a free flow condition and no significant signs of sediment, debris or vegetation were observed.
3. Control structures were found to be in good condition. Several were observed with accumulation of debris and/or overgrown vegetation in, around and on top of structures.
4. Treatment and conveyance swales and channels were found to be in good condition. There are several swales that have excessive vegetation, sediment and debris buildup that is restricting the free flow of stormwater.
5. A grated ditch bottom inlet was found to be in good condition, however, it has become overgrown with excessive vegetation and debris deposits which is restricting the free flow of stormwater into and out of the structure.
6. The weir structure on pond 12A had water flowing from the wetland tributary into the pond. Based on elevation readings in permitted plan set for permit 24192.011 sheet A-4 and the elevation reading for the opening of the weir found on sheet B-12 of the as built plan set for 24192.011 the water should be flowing out of the pond and not into the pond. This anomaly is resulting in elevated water levels in ponds 12, 12A, 13 and 13A and in the stormwater pipes and curb inlets.
7. There is an unpermitted structure crossing the conveyance swale from pond 12A to south tributary.
8. Remove fallen trees in north tributary at box culvert crossing under Observation Blvd. This is in phase 1 although the trees came down during the storms at the end of the 2024 hurricane season.

In general, the stormwater conveyance system within Phase 3 of Blackburn Creek CDD is in good condition. We have identified some minor maintenance activities in the following section which will enhance the ability of the system to convey stormwater through community more efficiently.


3.0 – RECOMMENDATIONS:

Based on our findings, BDI recommends the following maintenance activities be performed with in the next year:

1. Recommend the removal of vegetation, debris and sediment from control structures, grated swale inlet(s), drainage swales and channels as identified in the following exhibits.
2. Reecommend ongoing annual inspections of the drainage conveyance system in order to identify and mitigate issues at the earliest possible stage.
3. We also recommend that the CDD have regular and ongoing communication with the residents, contractors and vendors regarding the importance of preventing vegetation, debris and sediment from entering into the stormwater system. Implementing the following activities will help maintain the drainage system's ability to convey, attenuate and treat the stormwater within the community.
 - a. Eliminate power leaf blowing vegetation and debris into the street and drainage inlets.
 - b. Eliminate the application of excess mulch that is prone to movement during storm events.
 - c. Incorporate appropriate erosion control measures such as silt fence and inlet protection at active construction sites.
4. Recommend addressing Pond 12A weir to restore outflow of water from pond 12A into the wetland tributary. In addition this structure will need the missing skimmer board replaced.
5. There are two items included in this work that are in phase 2 of the community. Due to their impact on phase 3 conveyance we have included the following; 1) Clearning out an FES that conveys water from a wetland in phase 3 to a conveyance swale in phase 2 that outflows into the south tributary and 2) Clearing out overgrown and invasive vegetation where the south tributary exits along River Rd.
6. Removal of the unpermitted structure at pond 12A

APPENDIX A

Marked Plan Set Documents for Maintenance Work

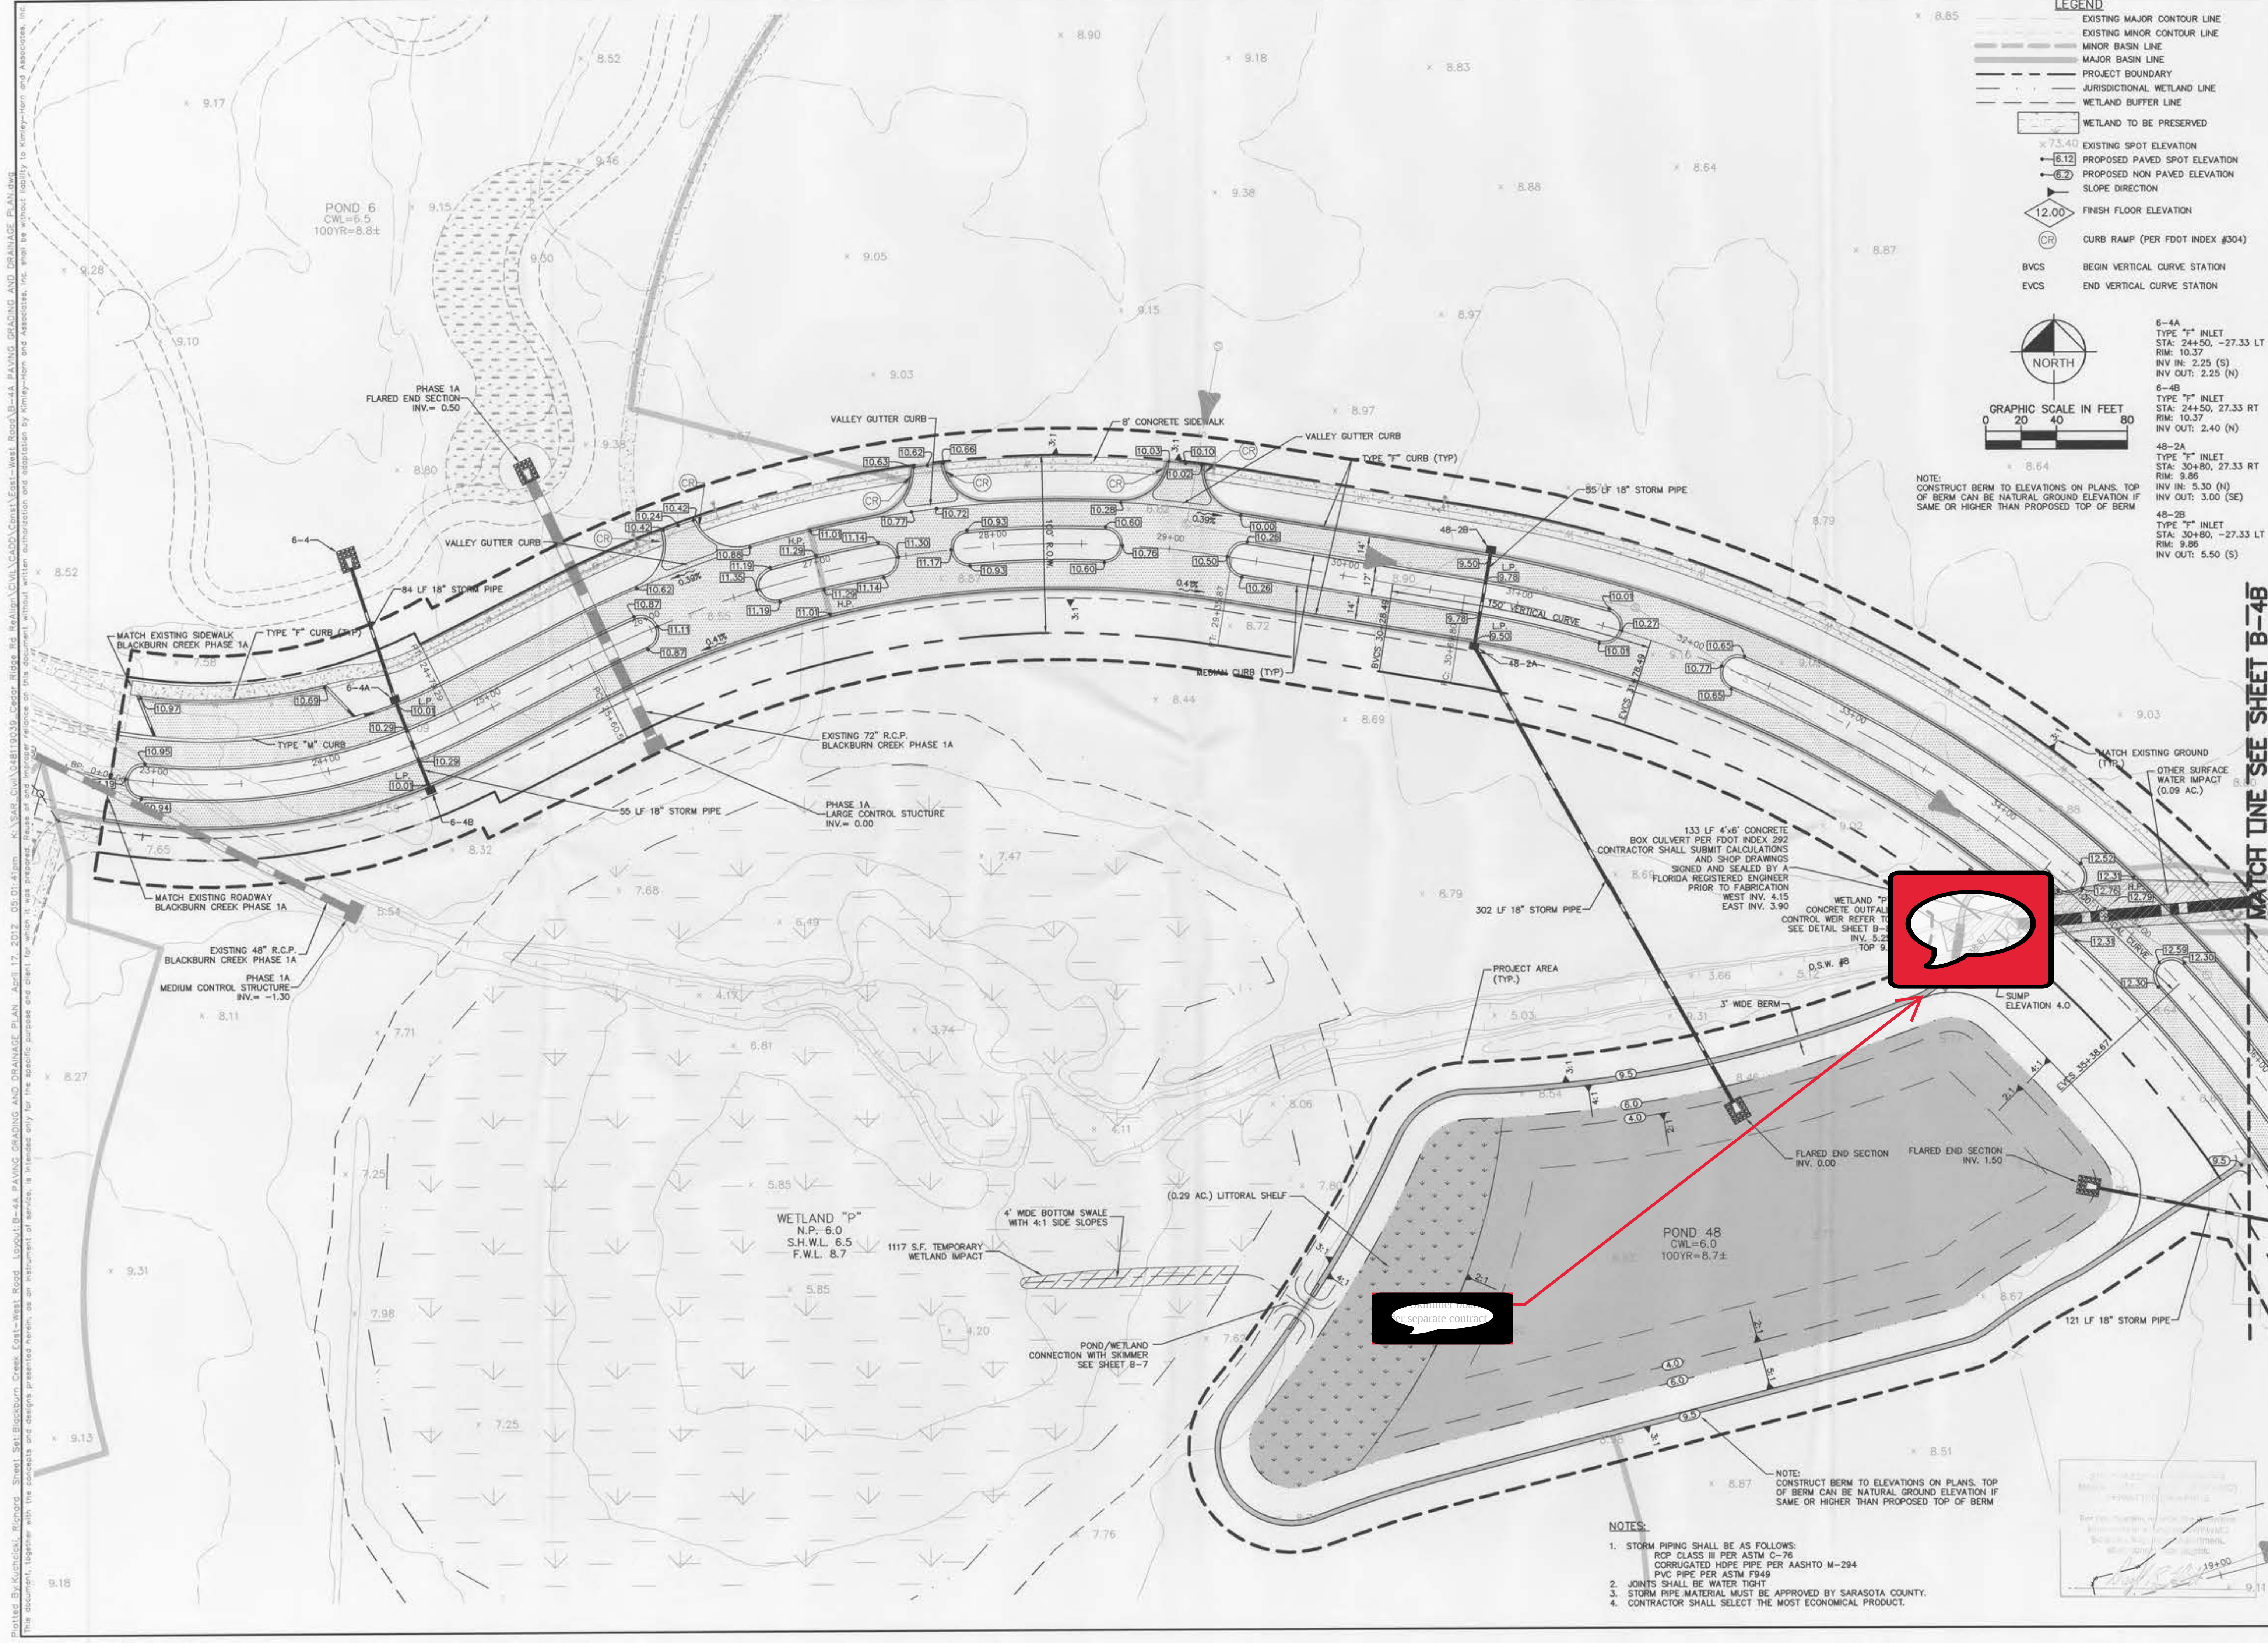

LEGEND

- EXISTING MAJOR CONTOUR LINE
- EXISTING MINOR CONTOUR LINE
- MAJOR BASIN LINE
- PROJECT BOUNDARY
- JURISDICTIONAL WETLAND LINE
- WETLAND BUFFER LINE
- WETLAND TO BE PRESERVED
- EXISTING SPOT ELEVATION
- PROPOSED PAVED SPOT ELEVATION
- PROPOSED NON PAVED ELEVATION
- SLOPE DIRECTION
- FINISH FLOOR ELEVATION
- CURB RAMP (PER FDOT INDEX #304)
- BVCS BEGIN VERTICAL CURVE STATION
- EVCS END VERTICAL CURVE STATION

GRAPHIC SCALE IN FEET
0 20 40 80

NOTE:
CONSTRUCT BERM TO ELEVATIONS ON PLANS. TOP OF BERM CAN BE NATURAL GROUND ELEVATION IF SAME OR HIGHER THAN PROPOSED TOP OF BERM

6-4A
TYPE "F" INLET
STA: 24+50, -27.33 LT
RM: 10.37
INV IN: 2.25 (S)
INV OUT: 2.25 (N)

6-4B
TYPE "F" INLET
STA: 24+50, 27.33 RT
RM: 10.37
INV IN: 5.30 (N)
INV OUT: 3.00 (SE)

48-2A
TYPE "F" INLET
STA: 30+80, -27.33 LT
RM: 9.86
INV IN: 5.50 (S)
INV OUT: 5.50 (S)

48-2B
TYPE "F" INLET
STA: 30+80, -27.33 LT
RM: 9.86
INV IN: 5.50 (S)
INV OUT: 5.50 (S)

Kimley-Horn and Associates, Inc.
© 2012 KIMLEY-HORN AND ASSOCIATES, INC.
2601 CATTLEMAN ROAD, SUITE 200, SARASOTA, FL 34232
PHONE: 941-379-7600 FAX: 941-379-4352
WWW.KIMLEY-HORN.COM CA 00000696

PROFESSIONAL ENGINEER
STATE OF FLORIDA
KIMLEY-HORN AND ASSOCIATES, INC.
KHA PROJECT 048119039
DATE FEB. 2012
SCALE AS SHOWN
DESIGNED BY KHA
DRAWN BY RBK
CHECKED BY TEC
DATE

PAVING GRADING AND DRAINAGE PLAN

GRAND PALM EAST-WEST ROAD
PREPARED FOR
RESOURCE CONSERVATION OF
SARASOTA, LLC

FLORIDA
SARASOTA COUNTY


SHEET NUMBER B-4A

DATE
BY

REVISIONS
No.



SWALE/SKIMMER SECTION
BETWEEN POND AND WETLAND
N.T.S.

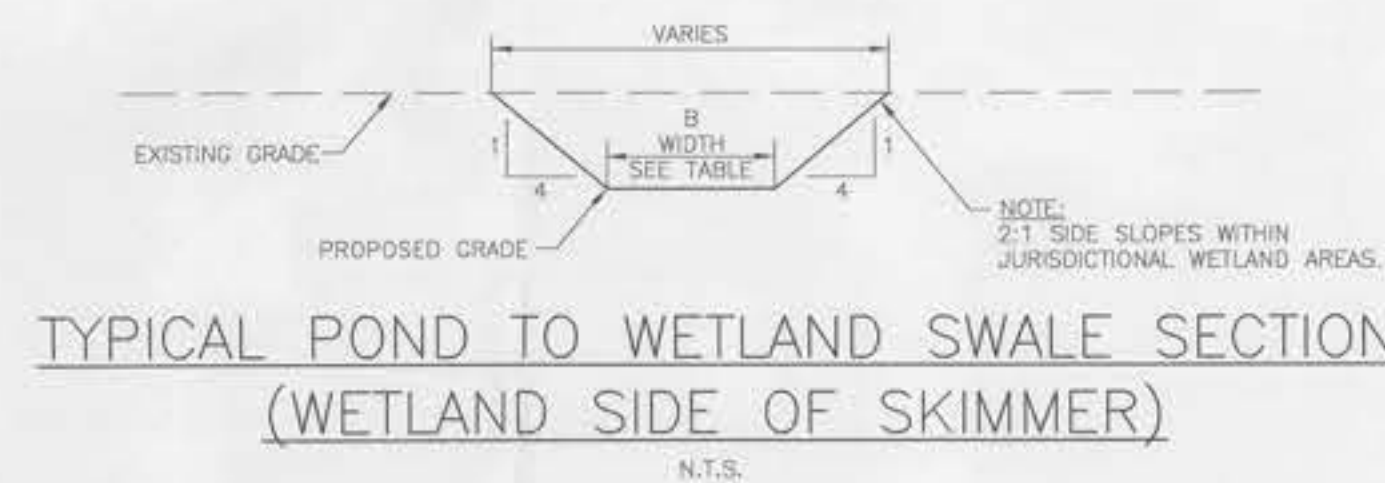

SOUTHWEST REGIONAL
MANAGEMENT DISTRICT
PERMITTED DRAWING

For construction permits, the Permittee shall comply with the SWRCB's
Section 400 Water Department,
when construction begins.

Diag. R. V. 114

[illegible]

POND WETLAND CONNECTION DETAILS

GRAND PALM EAST-WEST ROAD
PREPARED FOR
RESOURCE CONSERVATION OF
SARASOTA, LLC

SHEET NUMBER
B-7

KHA PROJECT	DATE	SCALE	AS SHOWN
048119039	FEB, 2012	DESIGNED BY	KHA
		DRAWN BY	RBK
		CHECKED BY	TEC



**Kimley-Horn
and Associates, Inc.**

© 2012 KIMLEY-HORN AND ASSOCIATES, INC.
2601 CATTLEMEN ROAD, SUITE 200, SARASOTA, FL 34232
PHONE: 941-379-7600 FAX: 941-379-4352
WWW.KIMLEY-HORN.COM CA 00000696

[illegible]

Plotted By: Kuchnicki, Richard Street Spt: Blockburn Creek East -West Road Loxvill/B-B Concrete Outfall Control NEIR April 12, 2012 05:10:15pm At: USAR_Civil\048119039_Cedar Ridge Rd Real\B-B Concrete Outfall Control NEIR.dwg

1. ALL CONCRETE SHALL HAVE A COMPRESSIVE STRENGTH OF AT LEAST 4000 P.S.I. @ 28 DAYS.
2. ALL STEEL TO HAVE A MINIMUM 3" CLEARANCE UNLESS OTHERWISE NOTED.
3. STEEL REINFORCEMENT SHALL MEET ASTM SPECIFICATIONS (A-615),
4. 3/4" CHAMFER ALL EXPOSED EDGES.
- ① 1/4" THICK ALUMINUM FABRICATED SKIMMER PLATE WITH OPEN TOP AND BOTTOM.
- ② 3/8" DIAMETER STAINLESS STEEL EXPANSION ANCHORS, 3" LONG (MIN.) WITH STEEL NUTS.



N.T.S.



1. OUTFALL SWALE BOTTOM SHALL BE 4' WIDE WITH 3:1 SIDE SLOPES THROUGH BUFFER AND 2:1 SIDE SLOPES IN WETLAND.
2. PLANT SWALE BOTTOM WITH SPARTINA BAKERI ON 2' CENTERS (INCLUDES SWALE SLOPES IN WETLAND AREA AND SWALE SLOPES BELOW WATER LEVEL).
3. SOD UPLAND AND BUFFER SWALE SLOPES.



**SOUTHWEST FLORIDA WATER
MANAGEMENT DISTRICT** (a Florida
NOT-FOR-PROFIT)

For construction awards, the Pe-
titioners, including the SWFW
Regional Navigation Department,
are construction begins.

Daryl R. Pitt

GRAND PALM EAST-WEST ROAD
PREPARED FOR
RESOURCE CONSERVATION OF
SARASOTA, LLC

SHEET NUMBER
B-8



**Kimley-Horn
and Associates, Inc.**

© 2012 KIMLEY-HORN AND ASSOCIATES, INC.
2601 CATTLEMAN ROAD, SUITE 200, SARASOTA, FL 34232
PHONE: 941-379-7600 FAX: 941-379-4352
WWW.KIMLEY-HORN.COM CA 00000696



KHA PROJECT	DATE	SCALE	AS SHOWN	DESIGNED BY	KHA	DRAWN BY	RBK	CHECKED BY	TEG
048119039	FEB. 2012								

77

TFEIR

—WOL

ETERO

CR
ON:

NO C

0	0
---	---

ROI	NOI	FLC
1	1	1
2	2	2
3	3	3
100	100	100



WES
R
VAT
LLCAST
RED
NSE
OTA

ALM PRE CE C SARA NTY

ND F
SOU
OTA C

GR	R	SARA
----	---	------

B-8

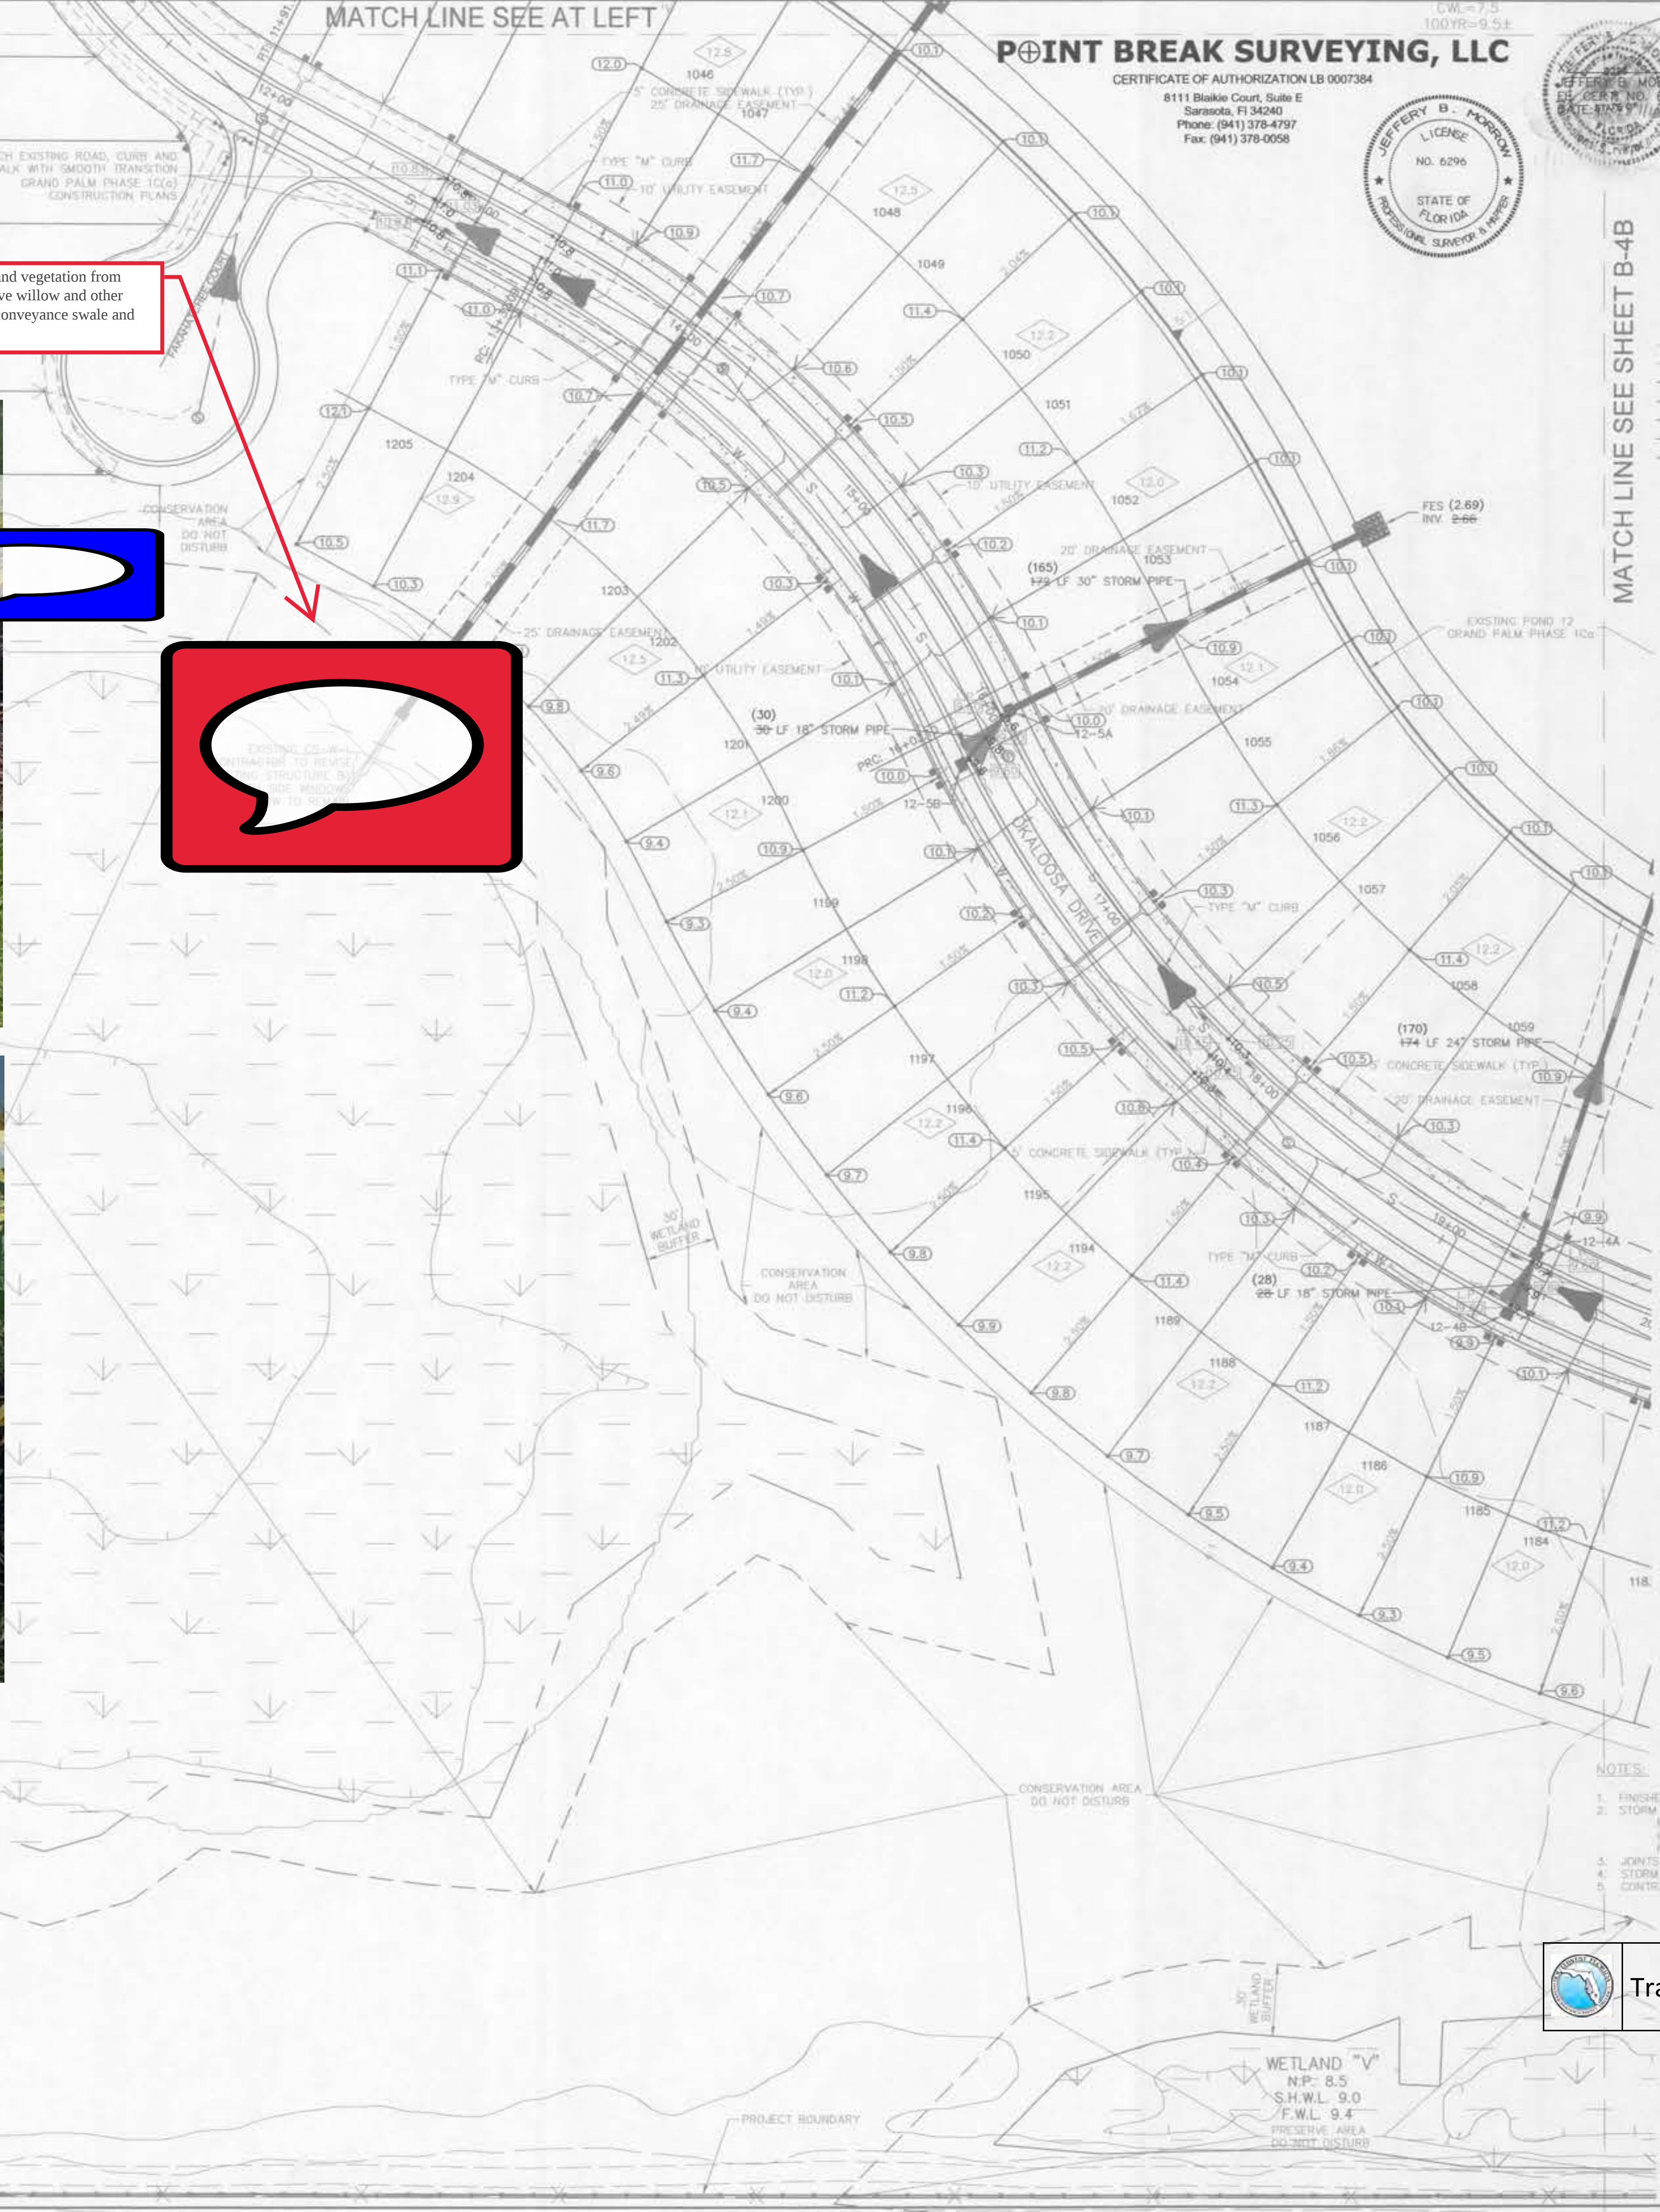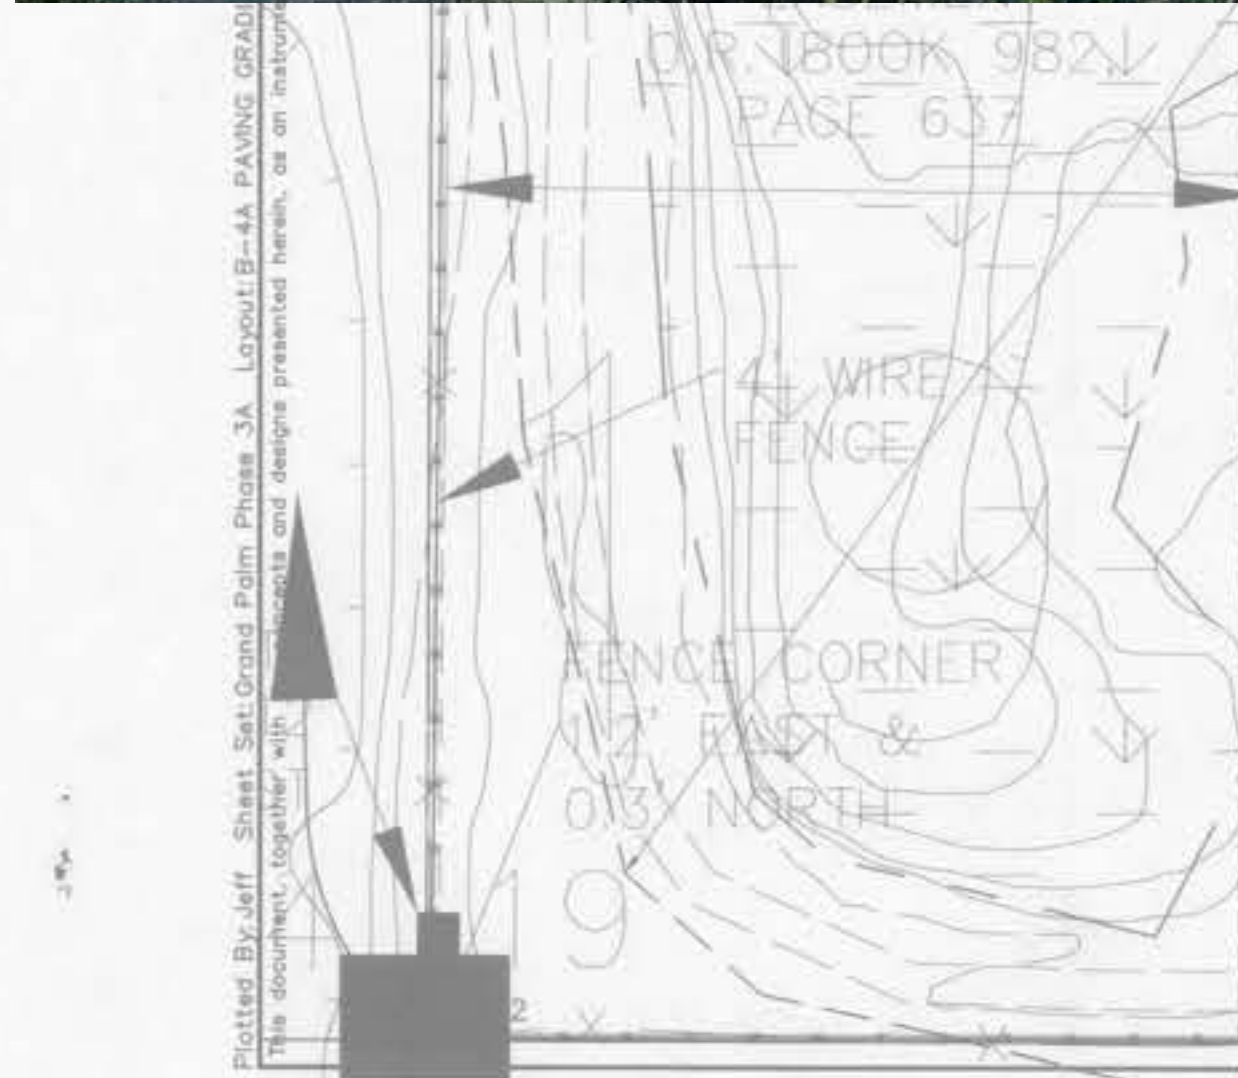

POINT BREAK SURVEYING, LLC

CERTIFICATE OF AUTHORIZATION LB 0007384

8111 Blakie Court, Suite E
Sarasota, FL 34240
Phone: (941) 378-4197
Fax: (941) 378-0058



ELEVATIONS SHOWN ARE RELATIVE TO
NATIONAL GEODETHIC VERTICAL DATUM
(NGVD) OF 1929 BASED ON SARASOTA
COUNTY BENCHMARK #7706 WITH A
PUBLISHED ELEVATION OF 9.88 FEET

LEGEND

- EXISTING MAJOR CONTOUR LINE
- EXISTING MINOR CONTOUR LINE
- MINOR BASIN LINE
- MAJOR BASIN LINE
- PROJECT BOUNDARY
- JURISDICTIONAL WETLAND LINE
- WETLAND BUFFER LINE
- WETLAND TO BE PRESERVED

- RECORD DRAWING NON PAVED & PAVED ELEVATION
- PROPOSED PAVED SPOT ELEVATION
- PROPOSED NON PAVED ELEVATION
- SLOPE DIRECTION
- MIN. FINISH FLOOR ELEVATION
- CURB RAMP (PER FOOT INDEX #304)

12-4A
TYPE M INLET
RIM: +9.96 (10.20)
INV IN: +5.42 (5.60)
INV OUT: +5.95 (5.05)

12-4B
TYPE M INLET
RIM: +9.96 (10.24)
INV IN: +5.48 (5.90)
INV OUT: +5.95 (5.05)

12-5A
TYPE M INLET
RIM: +9.96 (10.12)
INV IN: +5.91 (4.59)
INV OUT: +5.91 (3.54)

12-5B
TYPE M INLET
RIM: +9.96 (10.18)
INV OUT: +5.91 (4.76)

NOTES

- FINISHED PAD GRADE TO BE 10" BELOW FINISHED FLOOR ELEVATION
- STORM PIPING SHALL BE AS FOLLOWS:
60" CLASS III PER ASTM C-77
CORRUGATED HOPE PIPE PER AKHTO M-294
PVC PIPE PER ASTM F449
- JOINTS SHALL BE WATER TIGHT
- STORM PIPE MATERIAL MUST BE APPROVED BY SARASOTA COUNTY
- CONTRACTOR SHALL SELECT THE MOST ECONOMICAL PRODUCT



Transferred to Operation

Southwest Florida
Water Management District
OCT 28 2016
Received
Sarasota RSB

24192.011

Imaged As Is

KIMLEY-HORN		RECORD DRAWING		GRAND PALM PHASE 3A	
© 2016 KIMLEY-HORN AND ASSOCIATES, INC. 1777 MAIN STREET, SUITE 200, SARASOTA, FL 34236 PHONE: (941) 378-7600 WWW.KIMLEY-HORN.COM		PAVING GRADING AND DRAINAGE PLAN		PREPARED FOR RESOURCE CONSERVATION OF SARASOTA, LLC	
LISCENSED PROFESSIONAL THOMAS M. STOWALL FLORIDA LICENSE NUMBER 41224		KVA PROJECT 048119072 DATE DEC. 2014 SCALE AS SHOWN DESIGNED BY RKB DRAWN BY RKB CHECKED BY TMS DATE		FLORIDA	
No.		REVISIONS		SHEET NUMBER B-4A	
DATE		BY		SARASOTA COUNTY	



- LEGEND**
- EXISTING MAJOR CONTOUR LINE
 - EXISTING MINOR CONTOUR LINE
 - MAJOR BASIN LINE
 - PROJECT BOUNDARY
 - JURISDICTIONAL WETLAND LINE
 - WETLAND BUFFER LINE
 - WETLAND TO BE PRESERVED
 - RECORD DRAWING NON PAVED & PAVED ELEVATION
 - PROPOSED PAVED SPOT ELEVATION
 - PROPOSED NON PAVED ELEVATION
 - SLOPE DIRECTION
 - MIN. FINISH FLOOR ELEVATION
 - CURB RAMP (PER FOOT INDEX #384)

- NOTES:**
1. FINISHED PAD GRADE TO BE 10" BELOW FINISHED FLOOR ELEVATION
 2. STORM PIPING SHALL BE AS FOLLOWS:
RCP CLASS III PER ASTM C-76
CORRUGATED HDPE PIPE PER ASTM M-284
PVC PIPE PER ASTM F499
 3. JOINTS SHALL BE WATER TIGHT
 4. STORM PIPE MATERIAL MUST BE APPROVED BY SARASOTA COUNTY
 5. CONTRACTOR SHALL SELECT THE MOST ECONOMICAL PRODUCT

POINT BREAK SURVEYING, LLC
CERTIFICATE OF AUTHORIZATION LB 0007384
8111 Bahia Court, Suite E
Sarasota, FL 34240
Phone: (941) 378-4797
Fax: (941) 378-0058

- 12-3A
TYPE M INLET
42"x60" INSIDE SIZE
RM: 9.66 (10.08)
INV IN: 9.66 (10.21)
INV OUT: 9.66 (10.21)
- 12-3B
TYPE M INLET
42"x60" INSIDE SIZE
RM: 9.66 (10.08)
INV IN: 9.66 (10.21)
INV OUT: 9.66 (10.21)
- 13-2A
TYPE M INLET
42"x72" INSIDE SIZE
RM: 9.76
INV IN: 9.76 (3.28)
INV OUT: 9.76 (3.37)
- 13-2B
TYPE M INLET
42"x72" INSIDE SIZE
RM: 9.76
INV IN: 9.76 (3.28)
INV OUT: 9.76 (3.37)
- 13-3A
TYPE M INLET
RM: 9.66 (10.09)
INV IN: 9.66 (10.21)
INV OUT: 9.66 (10.4)
- 13-3B
TYPE M INLET
RM: 9.66 (10.19)
INV IN: 9.66 (10.21)
INV OUT: 9.66 (10.80)




Transferred to Operation


Kimley»Horn © 2016 KIMLEY-HORN AND ASSOCIATES, INC. 1777 MAIN STREET, SUITE 200 SARASOTA, FL 34236 WWW.KIMLEY-HORN.COM CA 0000896	
RECORD DRAWING PAVING GRADING AND DRAINAGE PLAN	
GRAND PALM PHASE 3A PREPARED FOR RESOURCE CONSERVATION OF SARASOTA, LLC	
SARASOTA COUNTY FLORIDA	
SHEET NUMBER Southwest Florida Water Management District	
OCT 28 2016 Received Sarasota BSA	
Imaged As Is	
KIMLEY-HORN AND ASSOCIATES, INC. 1777 MAIN STREET, SUITE 200 SARASOTA, FL 34236 WWW.KIMLEY-HORN.COM CA 0000896	
DESIGNED BY: KHA DRAWN BY: RKB CHECKED BY: TMS DATE: DEC. 2014	
KHA PROJECT 048119072	
DATE DEC. 2014	
SCALE AS SHOWN	
DESIGNED BY: KHA DRAWN BY: RKB CHECKED BY: TMS DATE: DEC. 2014	
LICENSURE PROFESSIONAL THOMAS M. STOVALL FLORIDA LICENSE NUMBER 41224	
REVISED	
DATE	
BY	

[illegible]

MATCH LINE SEE SHEET B-4B

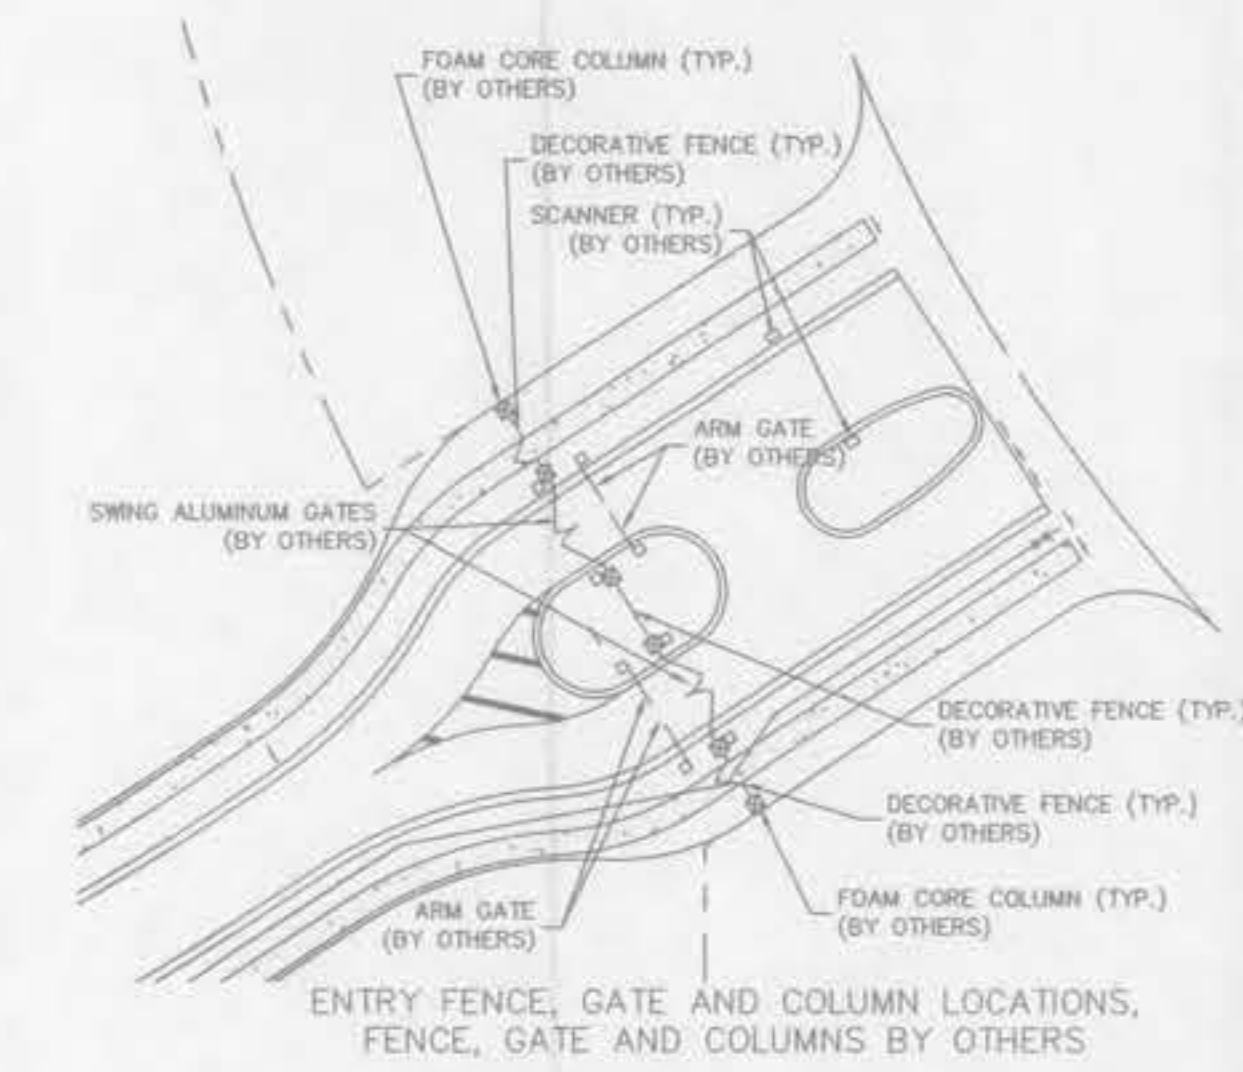

- NOTES:
1. FINISHED PAD GRADE TO BE 10" BELOW FINISHED FLOOR ELEVATION
 2. STORM PIPING SHALL BE AS FOLLOWS:
 RCP CLASS IV PER ASTM C-76
 CORRUGATED HDPE PIPE PER AASHTO M-294
 PVC PIPE PER ASTM F441
 3. JOINTS SHALL BE WATER TIGHT
 4. STORM PIPE MATERIAL MUST BE APPROVED BY SARASOTA COUNTY
 5. CONTRACTOR SHALL SELECT THE MOST ECONOMICAL PRODUCT.

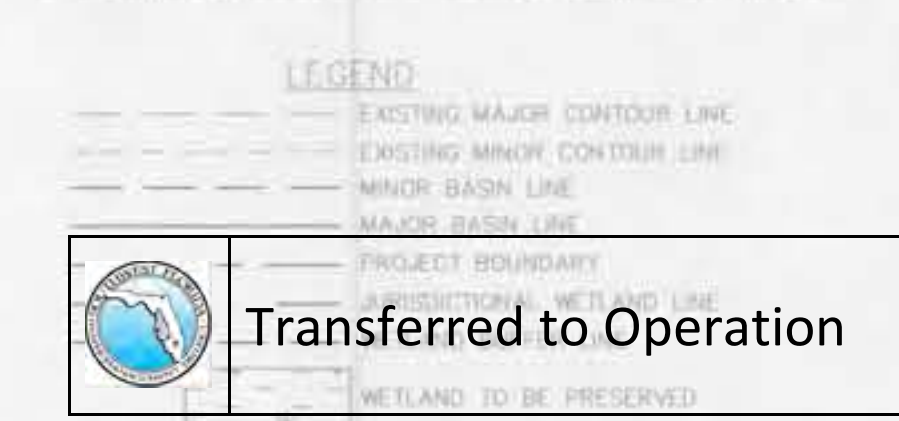

JEFFERY B. MORROW, P.S.A.
FL CERT. NO. 6296
DATE: 12/21/10



P⊕INT BREAK SURVEYING, LLC
 CERTIFICATE OF AUTHORIZATION LB 0007384
 8111 Blaikie Court, Suite E
 Sarasota, FL 34240
 Phone: (941) 378-4797
 Fax: (941) 378-0058



Southwest Florida
Water Management District
OCT 28 2016
Received
Sarasota RSR

Southwest Florida
Water Management District
OCT 28 2016
Received
Sarasota BSE

SHEET NUMBER
B-4C

GRAND PALM PHASE 3A PREPARED FOR RESOURCE CONSERVATION OF SARASOTA, LLC SARASOTA COUNTY FLORIDA	RECORD DRAWING PAVING GRADING AND DRAINAGE PLAN	KHA PROJECT 048119072	LICENSED PROFESSIONAL	Kimley»»Horn © 2014 KIMLEY-HORN AND ASSOCIATES, INC. 1777 MAIN STREET, SUITE 200, SARASOTA, FL 34236 PHONE: 941-379-7600 WWW.KIMLEY-HORN.COM CA 00000686	No.	
		DATE DEC. 2014	THOMAS W. STOVALL			
		SCALE AS SHOWN	FLORIDA LICENSE NUMBER 41224			
		DESIGNED BY KHA				
		DRAWN BY RBK				
		CHECKED BY TMS	DATE			
				ADJUSTED LOT LINES AND ASSOCIATED GRADING	1/02/2016	RBK
				ADJUSTED LOT LINES	8/19/2015	RBK
				ADDED BERM, REQUIRED EMERGENCY ACCESS	4/24/2015	RBK
				REVISIONS	DATE	BY

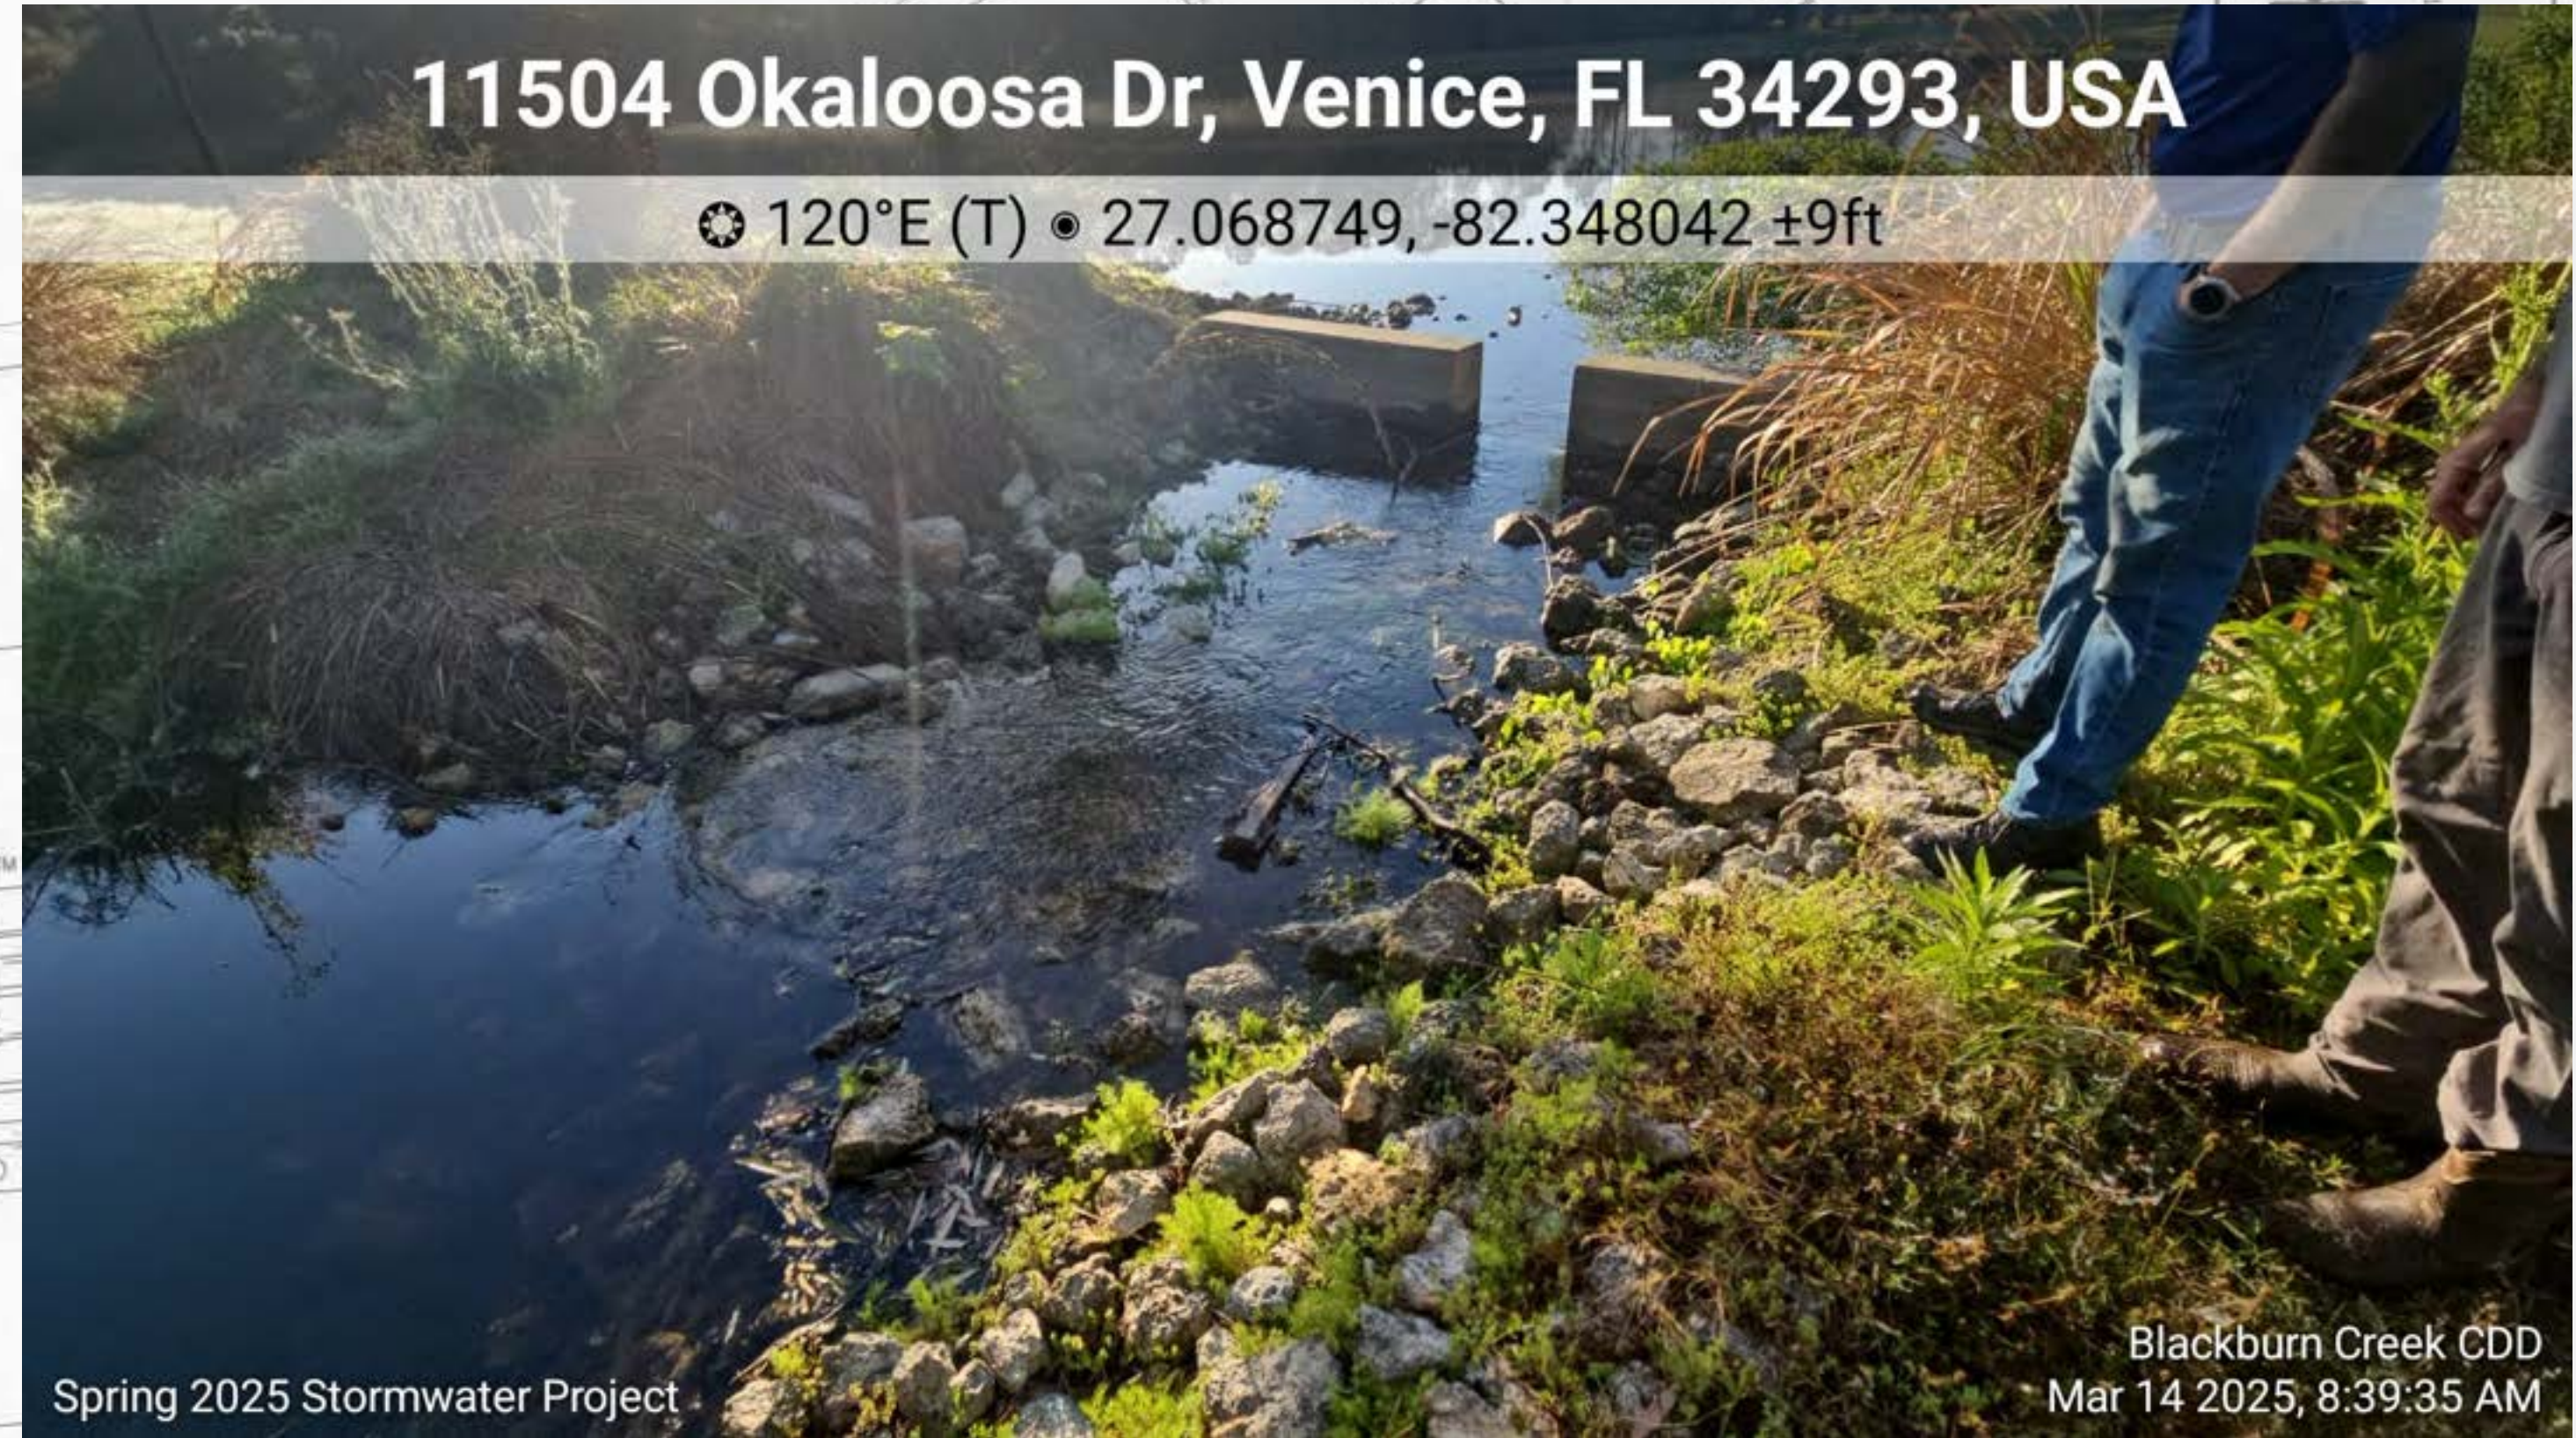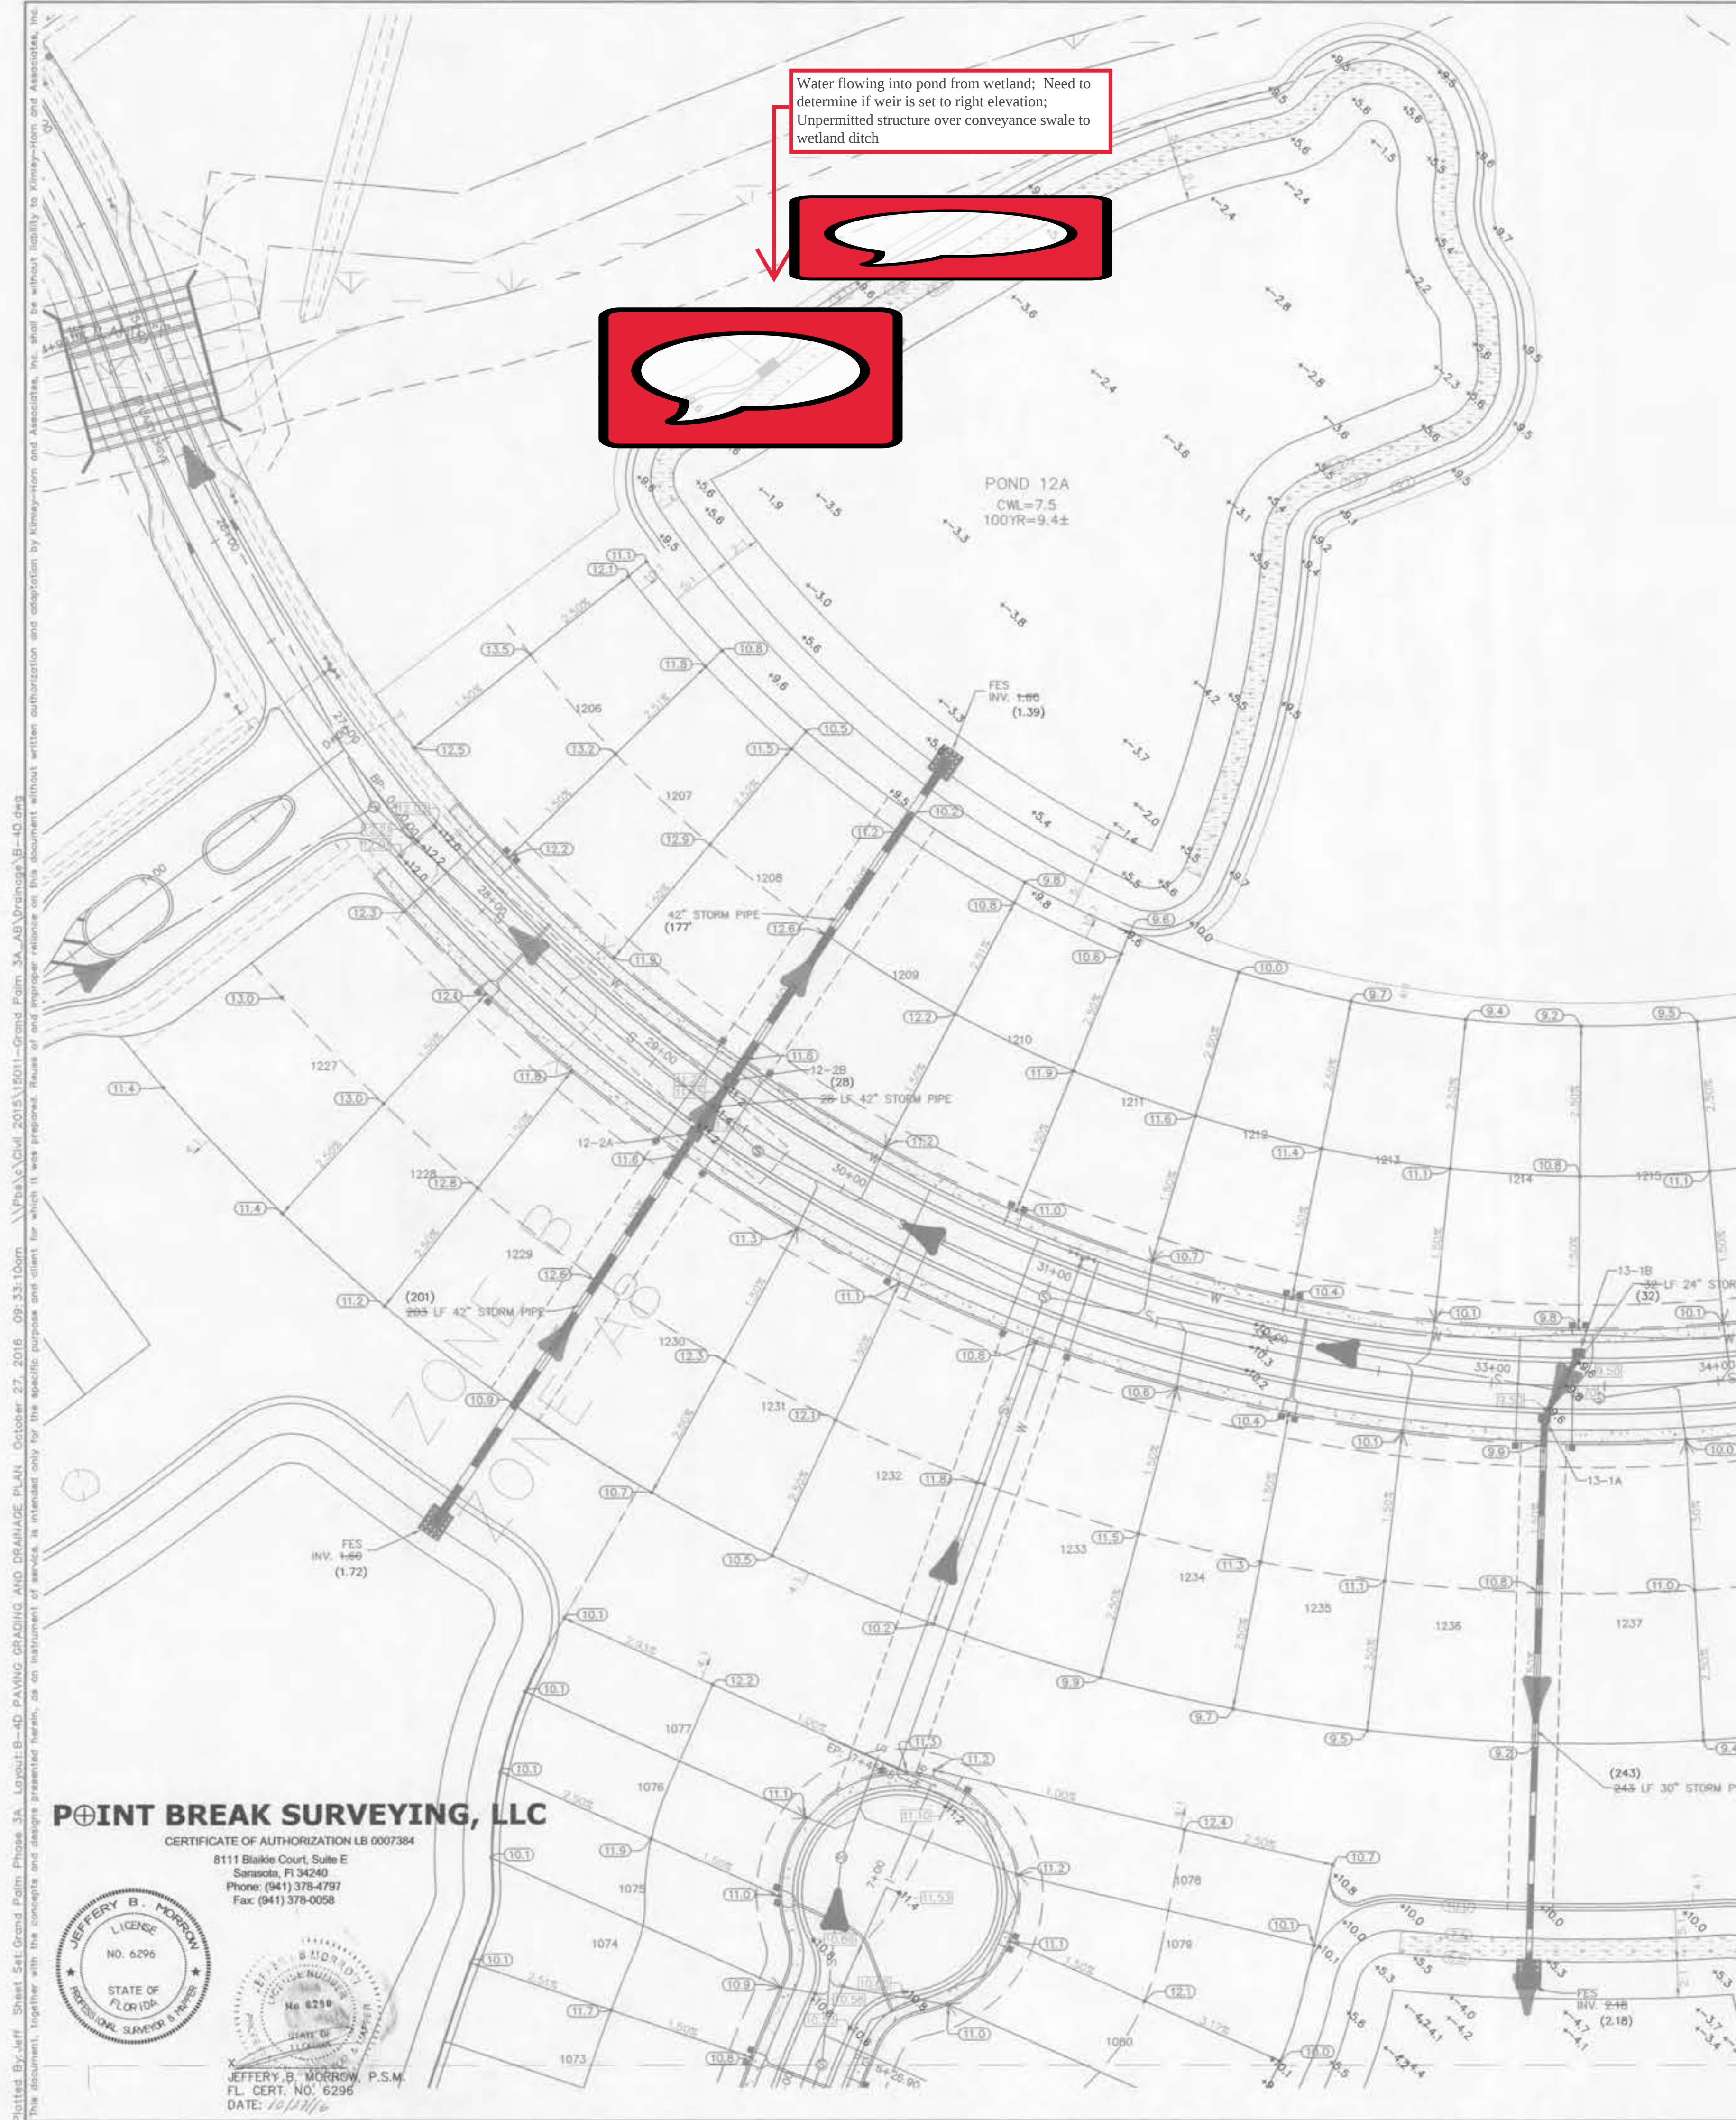

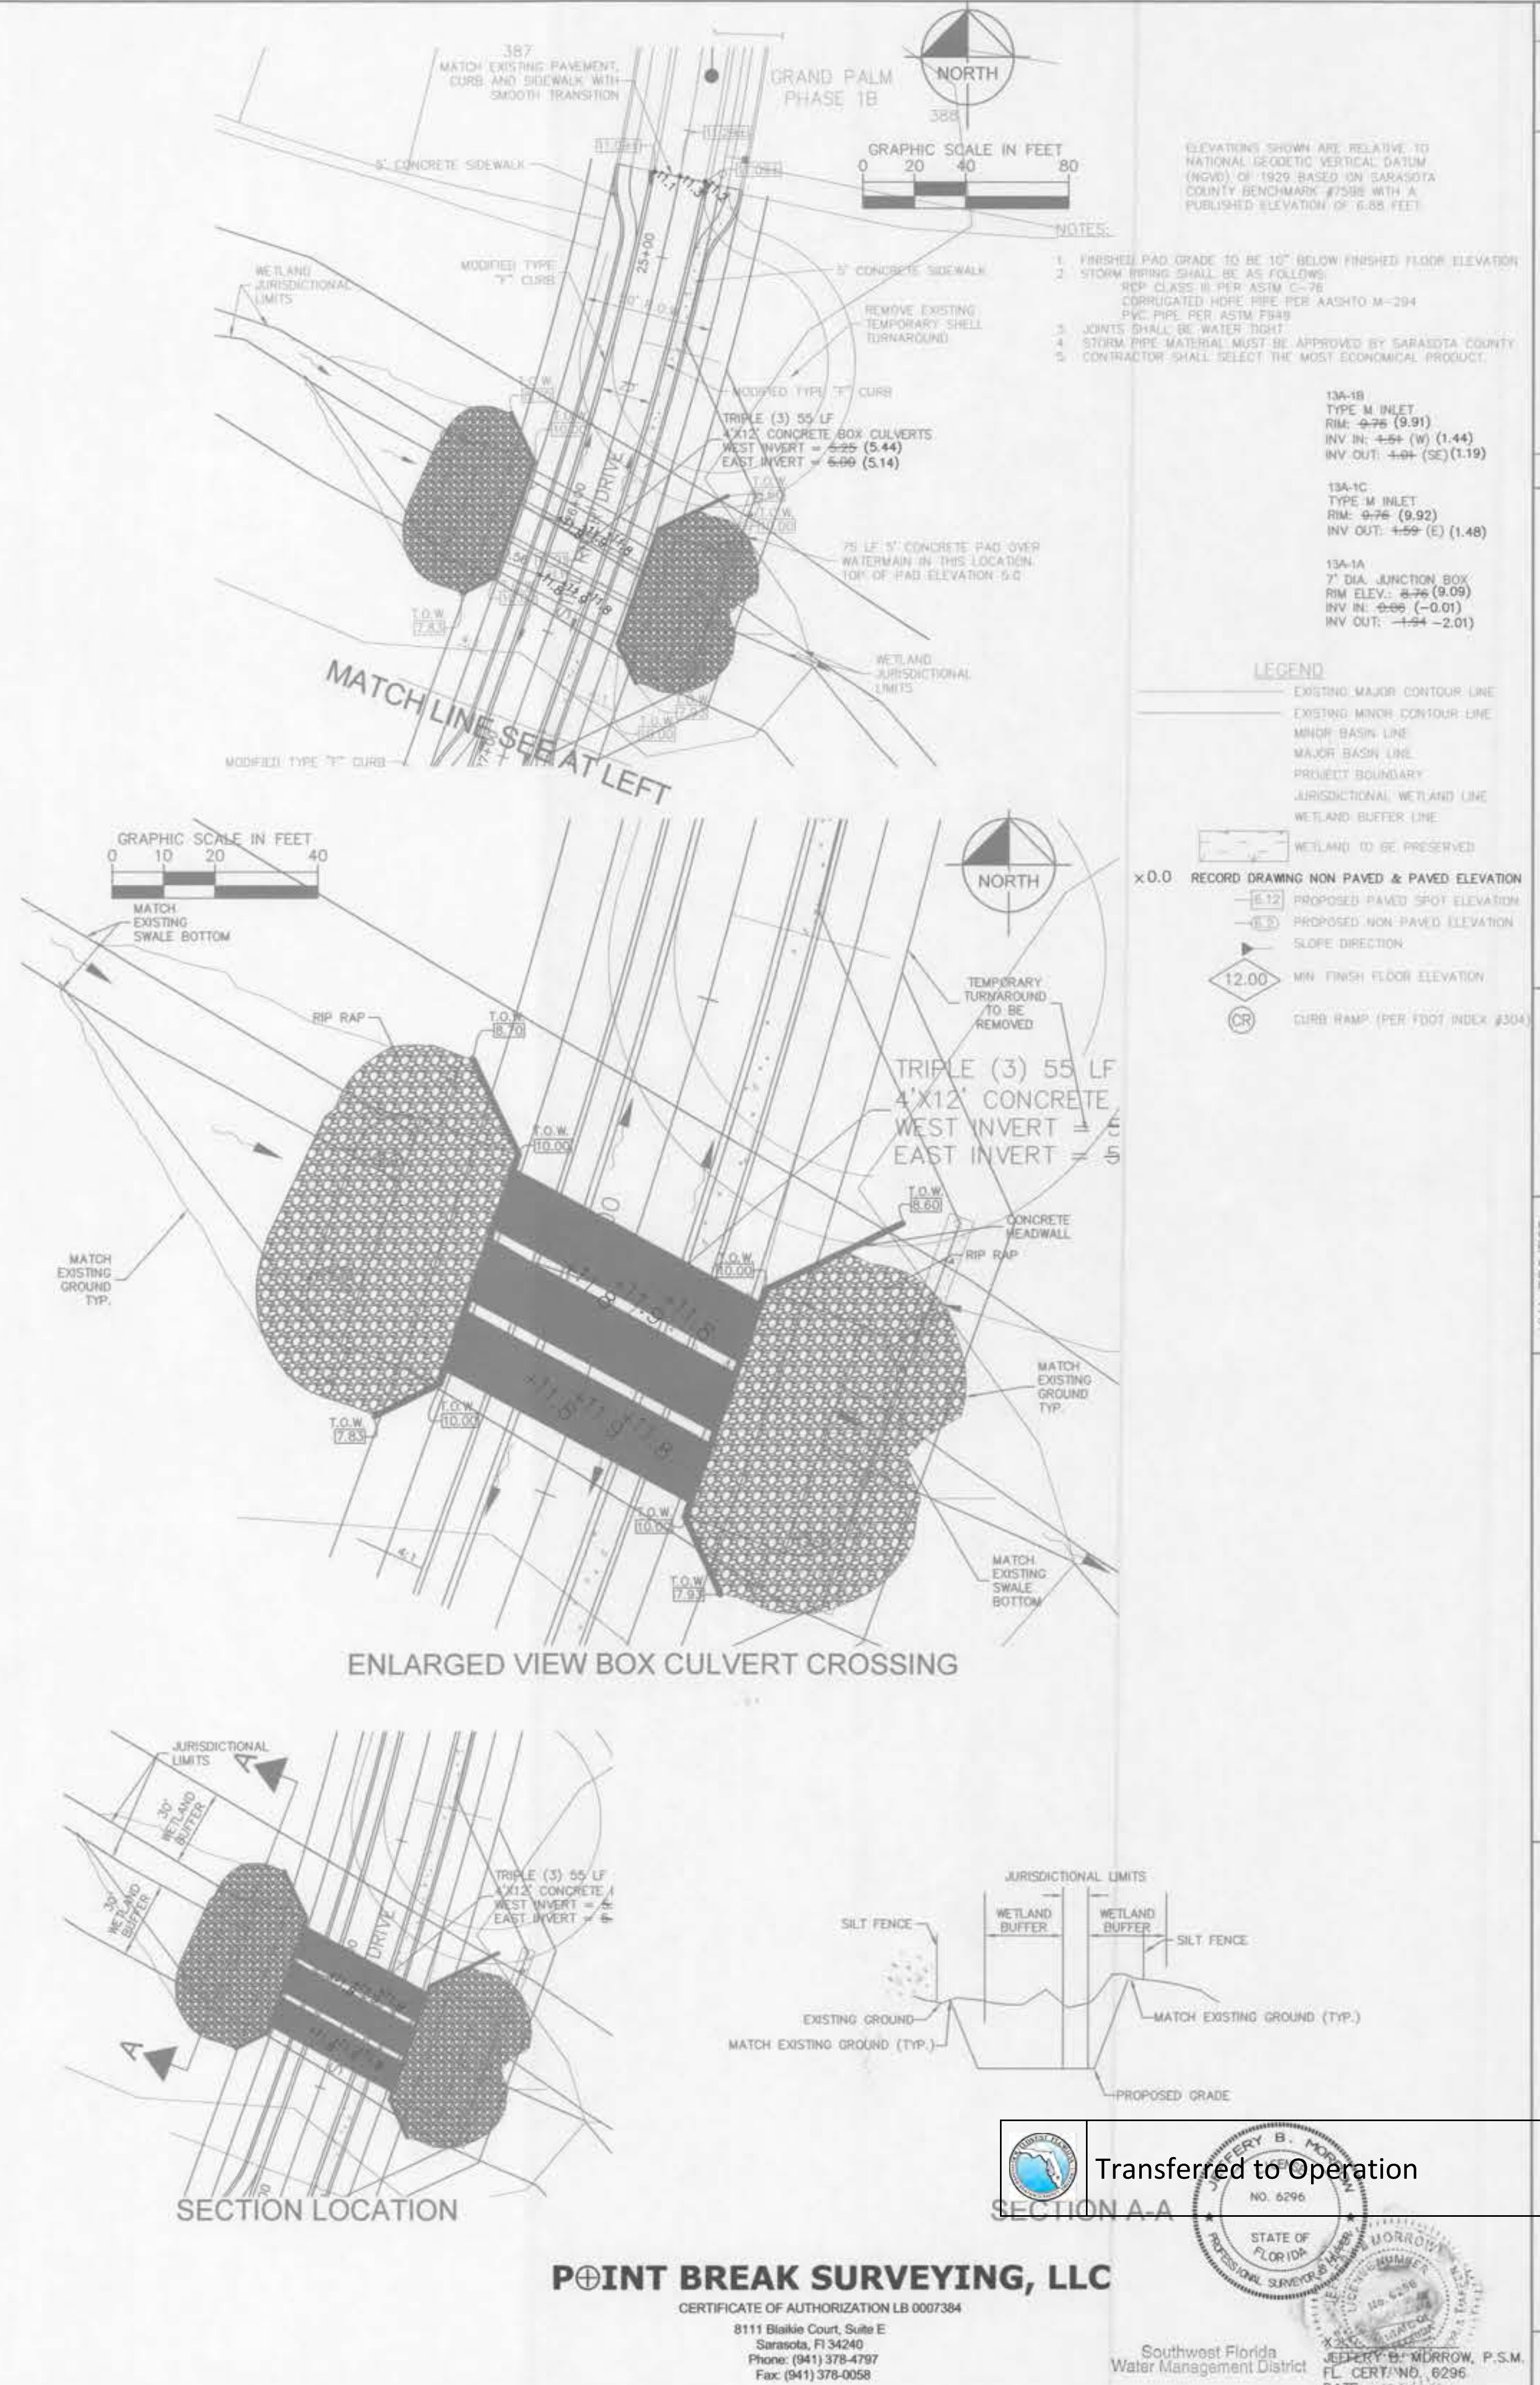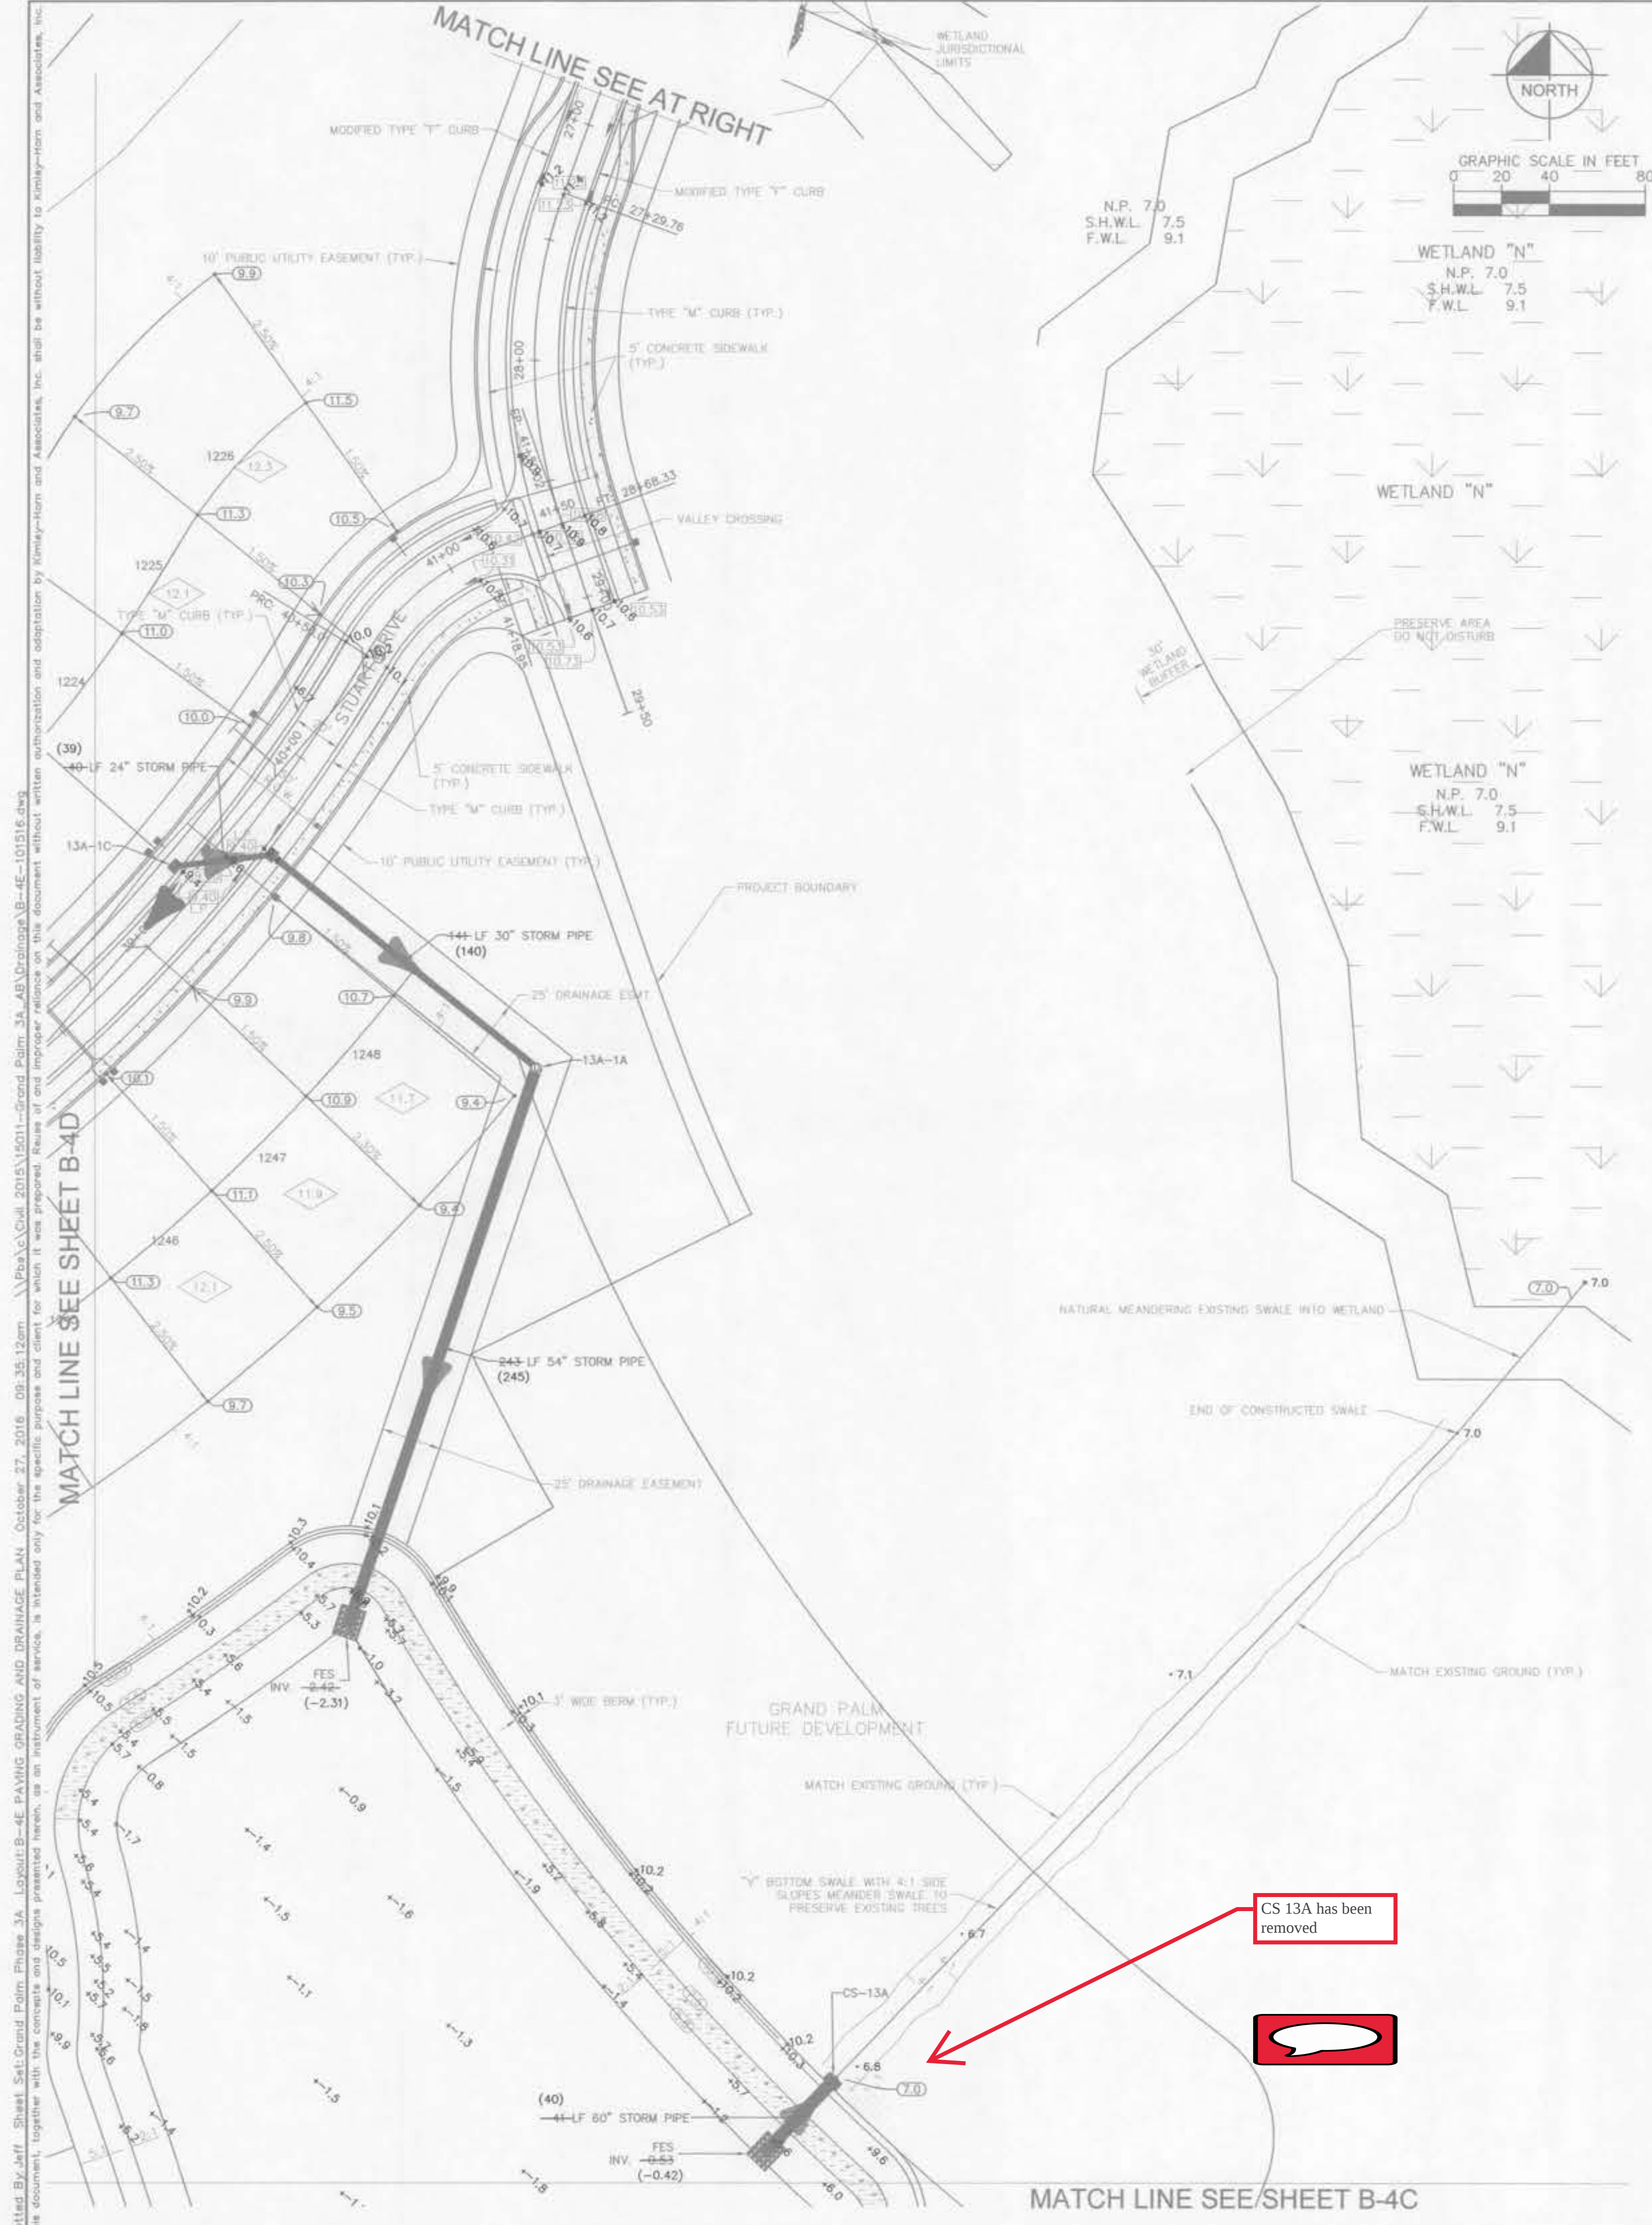

9/14/2015
REK

9/14/2015
REK

9/14/2015
REK

9/14/2015
REK

ADJUSTED LOT LINES

MOVED BOX CULVERTS AND WATERMAN

REVISED ELEVATION ACCESS

REVISIONS

No.

DATE

BY

Kimley»Horn

© 2016 KIMLEY-HORN AND ASSOCIATES, INC.
1777 MAIN STREET, SUITE 300, FL 34236
WWW.KIMLEY-HORN.COM

THOMAS M. STOVALL

FLORIDA LICENSE NUMBER 41224

KHA PROJECT 048119072

DATE: DEC. 2014

SCALE: AS SHOWN

DESIGNED BY: KHA

DRAWN BY: REK

CHECKED BY: TMS

DATE:

RECORD DRAWING

PAVING GRADING

AND DRAINAGE PLAN

GRAND PALM PHASE 3A

PREPARED FOR

RESOURCE CONSERVATION OF SARASOTA, LLC

FLORIDA

SARASOTA COUNTY

SHEET NUMBER B-4E

Plotted By: jef. Sheet S4-Grand Palm Phase 3A. Layout B-4E PAVING GRADING AND DRAINAGE PLAN. October 27, 2016. 09:35:12am. \\Psa\c\c\c\2015\19072-Grand Palm 3A_A4B\Drawings\B-4E-101516.dwg
This document, together with the concepts and designs presented herein, is intended only for the specific purpose and client for which it was prepared. Reuse of this document without written authorization and adaptation by Kimley-Horn and Associates, Inc. shall be without liability to Kimley-Horn and Associates, Inc.

POINT BREAK SURVEYING, LLC
CERTIFICATE OF AUTHORIZATION LB 0007384
8111 Blakie Court, Suite E
Sarasota, FL 34240
Phone: (941) 378-4797
Fax: (941) 378-0058

Transferred to Operation
JERRY B. MORROW, P.S.M.
No. 6296
STATE OF FLORIDA
PROFESSIONAL SURVEYOR
OCT 26 2016
Received
Sarasota RSB
Imaged As Is

Plotted By: Jeff Sheet Set: Grand Palm Phase 3A Layout: B-12 CONCRETE OUTFALL CONTROL WER DETAILS October 27, 2016 09:39:33am



- ① 1/4" THICK ALUMINUM FABRICATED SKIMMER PLATE WITH OPEN TOP AND BOTTOM.
- ② 3/8" DIAMETER STAINLESS STEEL EXPANSION ANCHORS, 3" LONG (MIN.) WITH STAINLESS STEEL WASHERS.



N.T.S.



N.T.S.

1. OUTFALL SWALE BOTTOM SHALL BE 4' WIDE WITH 3:1 SIDE SLOPES THROUGH BUFFER AND 2:1 SIDE SLOPES IN WETLAND.
2. PLANT SWALE BOTTOM WITH SPARTINA BAKERI ON 2' CENTERS (INCLUDES SWALE SLOPES IN WETLAND AREA AND SWALE SLOPES BELOW WATER LEVEL).
3. SOD UPLAND AND BUFFER SWALE SLOPES.

NOTE: PLAN, SECTIONS
AND DETAILS SHOWN ARE
NOT TO ANY SCALE.

CERTIFICATE OF AUTHORIZATION LB 0007384

Transferred to Operation

OCT 28 2010

Sarasota RSB

JEFFERT B. MURROW, P.S.M.
FL. CERT. NO: 6296
DATE: 10/27/10

Imaged As Is

RECORD DRAWING
CONCRETE OUTFALL
CONTROL WEIR
DETAILS

GRAND PALM PHASE 3A
PREPARED FOR
RESOURCE CONSERVATION OF
SARASOTA, LLC

SHEET NUMBER
B-12

Kimley»»Horn
© 2016 KIMLEY-HORN AND ASSOCIATES, INC.
2501 CATTLEMAN ROAD, SUITE 200, SARASOTA, FL 34232
PHONE: 941-578-7600 FAX: 941-379-4352
WWW.KIMLEY-HORN.COM CA 00000896

LICENSED PROFESSIONAL
THOMAS M. STOVALL
FLORIDA LICENSE NUMBER
41224

KHA PROJECT	DATE	SCALE	AS SHOWN
048119072	DEC. 2014	DESIGNED BY	KHA
		DRAWN BY	RBH

AWING
UTFALL
WEIR

CORD D
CRETE
NTROL
DETAIL

RECONCILIATION

PHASE 3
FOR
SERVATION
A, LLC

AND PAL
PREPAR
SOURCE CON
SARASCO

SHEET NUMBER
B-12

Plotted By: jef. Sheet S41-Grand Palm Phase 3A. Layout: B-19 MODIFIED CONTROL STRUCTURE CS-W-L. October 27, 2018 09:41:01am
This document, together with the spreads and design presentation herein, is intended only for the specific purpose and client for which it was prepared. Review it and make any changes only if you are authorized to do so. No other use or reproduction is permitted without the written authorization of the designer. The designer assumes no responsibility for any errors or omissions in this document, and no liability for any damages, including consequential damages, arising from the use of this document.

POINT BREAK SURVEYING, LLC


CERTIFICATE OF AUTHORIZATION LB 0007384
8111 Blake Court, Suite E
Sarasota, FL 34240
Phone: (941) 378-4797
Fax: (941) 378-0058




CONTROL STRUCTURE NO.	TOP OF STRUCTURE / GRATE ELEV.	FLOWLINE WINDOW ELEV.	RECTANGULAR WEIR SIZE (SLOT) (WINDOWS)				ORIFICE ELEV.	ORIFICE GEOMETRY	PIPE SIZE	OUTFALL PIPE INVERT	SKIMMER YES/NO	SPECIAL COMMENT
			FRONT	REAR	SIDES	TOTAL						
CS-W-L	9.7	8.5				3.0'			36"	4.0		
RECORD DATA			(3')			(3')						
RECORD DATA												
RECORD DATA												
** ALL BUBBLER BOXES SHALL HAVE AN INSIDE BOTTOM ELEVATION 18" BELOW PIPE INVERT. THE CONTRACTOR IS REQUIRED TO PROTECT THESE SUMPS AND PIPES FROM DEBRIS AND SILTATION. ALL PIPES AND SUMPS SHALL BE FREE OF DEBRIS AND SILTATION AT FINAL PROJECT ACCEPTANCE. DO NOT POUR INVERTS IN BUBBLER BOXES.


- 1/4" THICK ALUMINUM FABRICATED SKIMMER PLATE WITH OPEN TOP AND BOTTOM.
- 3/8" DIAMETER STAINLESS STEEL EXPANSION ANCHORS, 3" LONG (MIN.) WITH STAINLESS STEEL WASHERS AND NUTS 60° MAXIMUM. TWO MIN. REQUIRED EACH SIDE OF SKIMMER.
- 3/16" THICK NEOPRENE GASKET BETWEEN SKIMMER AND CONCRETE.

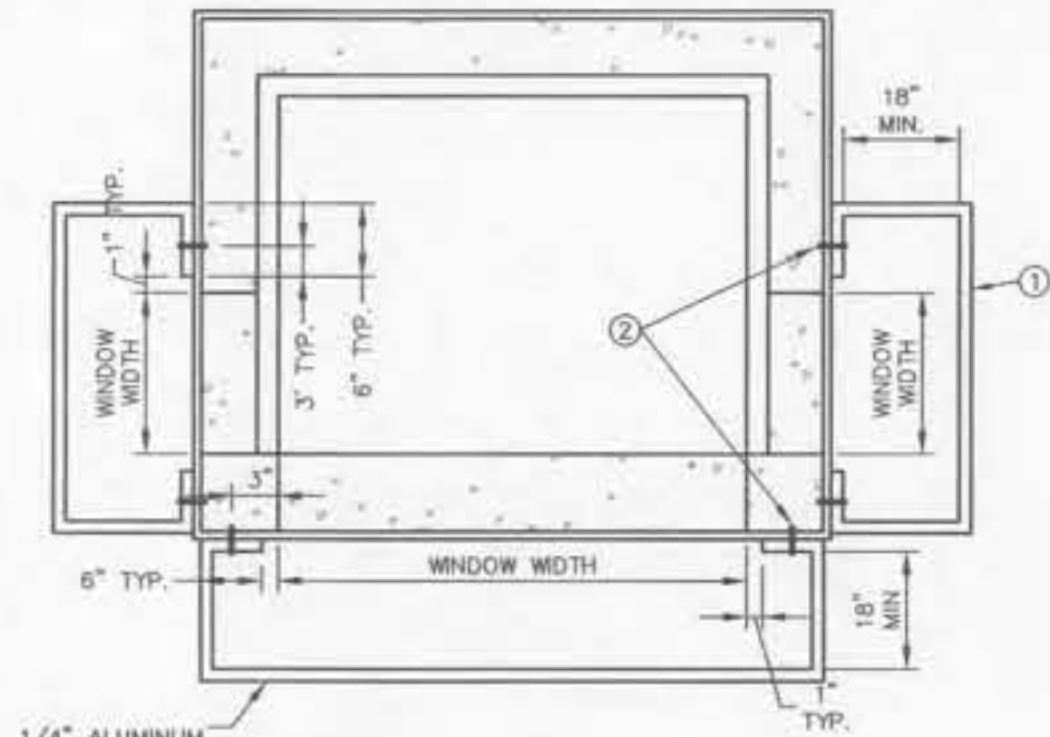


SKIMMER PLATE DETAIL TOP VIEW

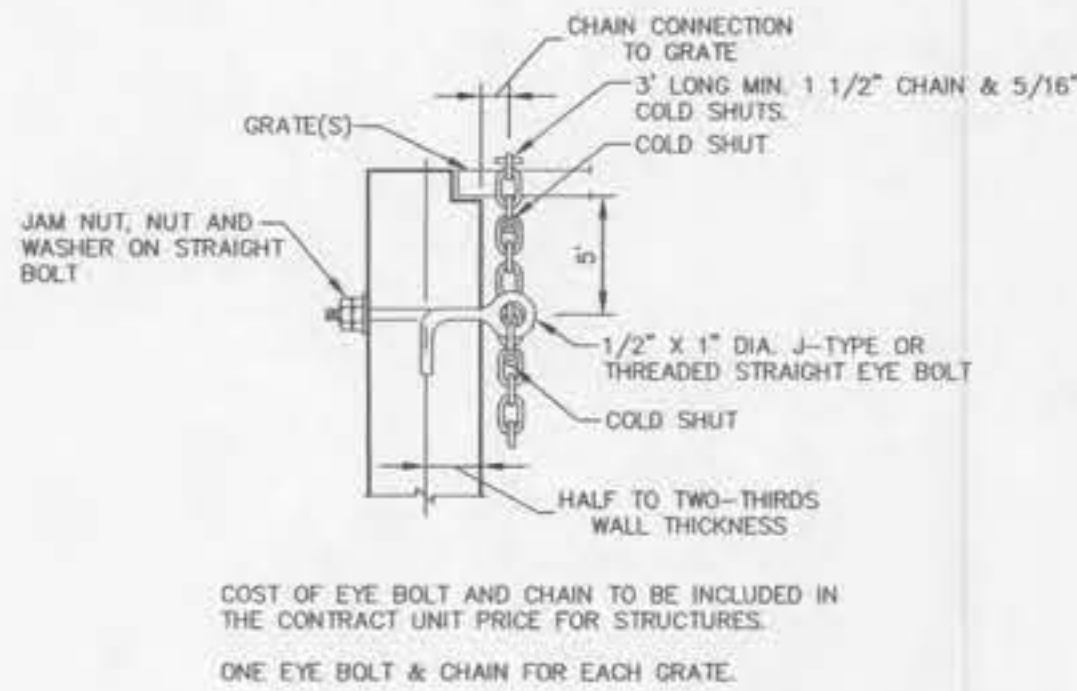


EYE BOLT AND CHAIN FOR LOCKING GRATES TO STRUCTURES
N.T.S.

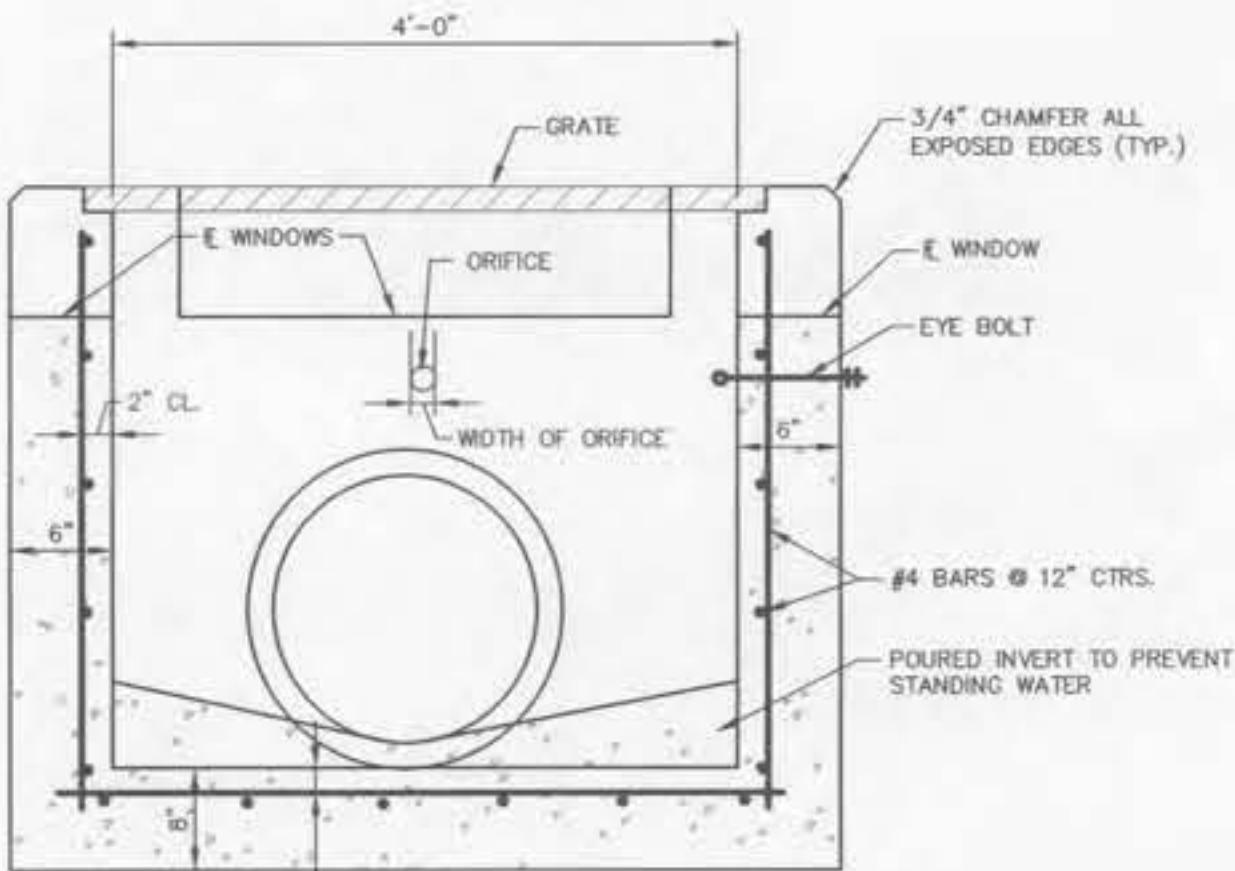


SECTION

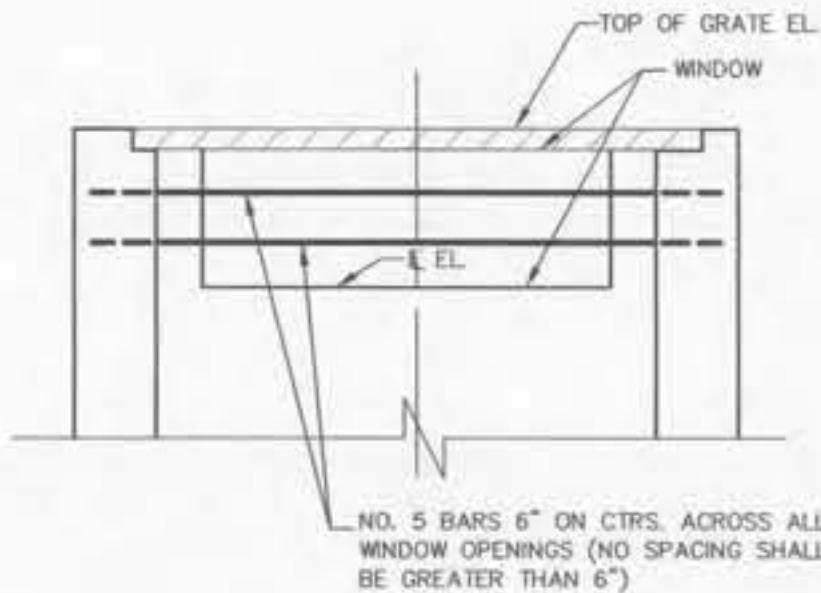


SECTION

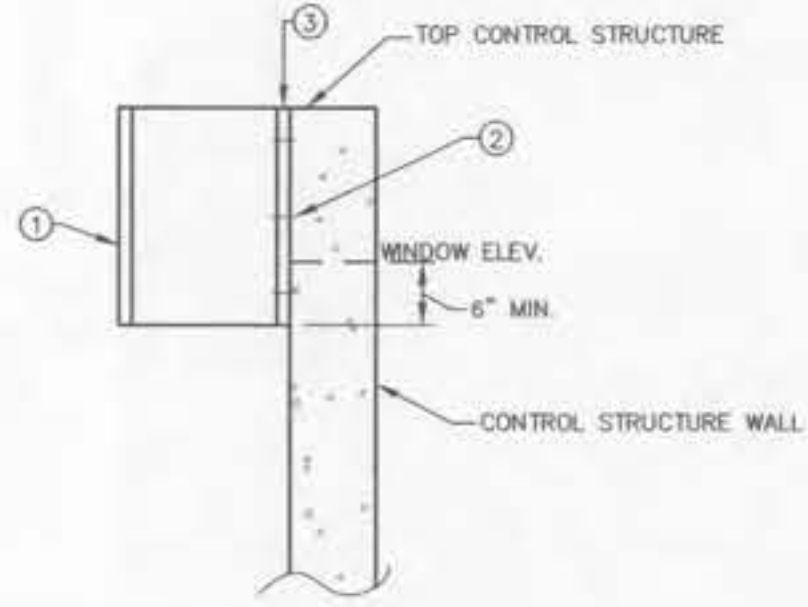


SKIMMER PLATE DETAIL SIDE VIEW

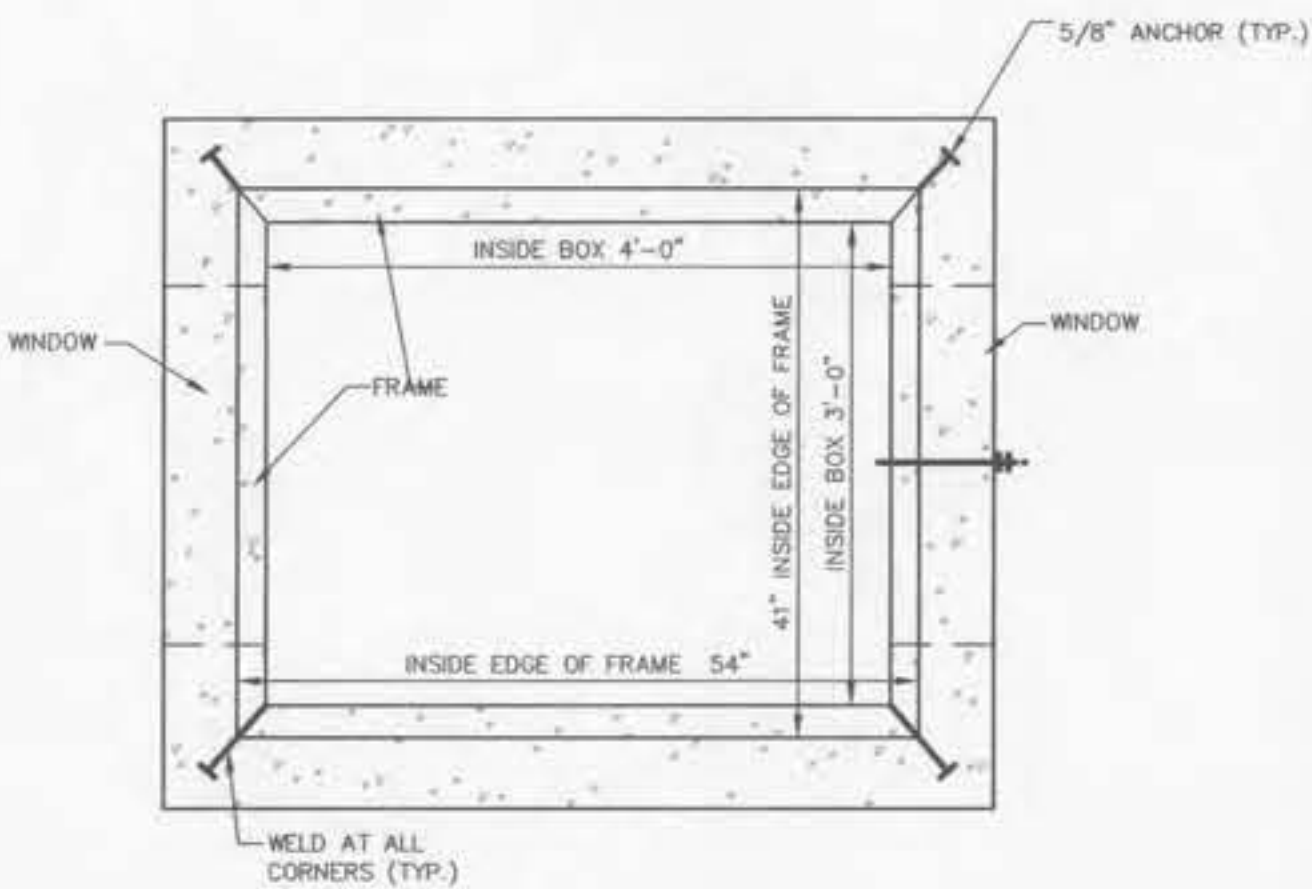

PLAN

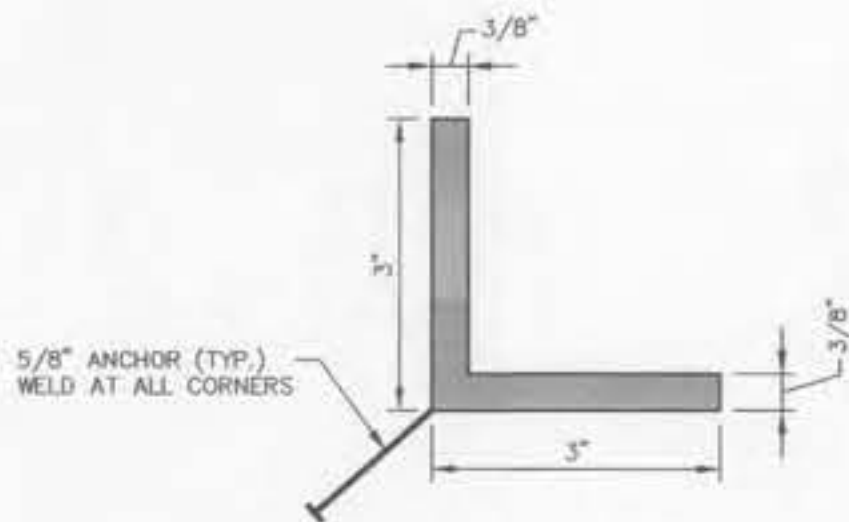

STEEL FRAME DETAIL
(ALL FOUR SIDES WELDED TOGETHER)

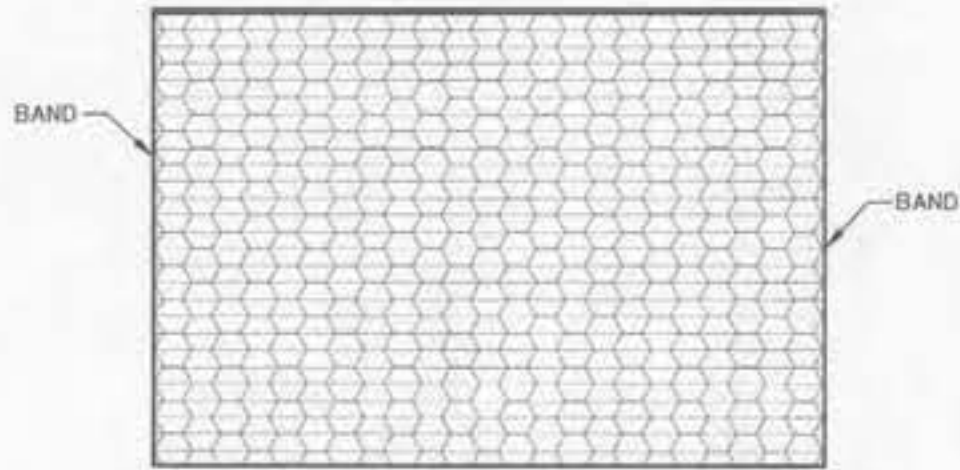



GALVANIZED STEEL GRATE USE
(52-1116614 x 2')

NOTES:

- ALL CONCRETE SHALL HAVE A COMPRESSIVE STRENGTH OF AT LEAST 4000 P.S.I. @ 28 DAYS
- ALL STEEL TO HAVE A MINIMUM 2" CLEARANCE UNLESS OTHERWISE NOTED.
- STEEL REINFORCEMENT SHALL MEET ASTM SPECIFICATIONS (A-615), DEFORMED BARS.
- ALL INLETS TO HAVE FIELD POURED INVERTS TO ELIMINATE STANDING WATER.
- 3/4" CHAMFER ALL EXPOSED EDGES.
- ALL EXPOSED STEEL AND IRON SHALL HAVE ONE SHOP COAT RUST INHIBITOR AND ONE FIELD COAT OF KOPPERS 300 BITUMASTIC EPOXY BASED PAINT, 8 MILS D.F.T.

SEE PAVING, DRAINAGE AND GRADING PLANS FOR PIPE SIZES, LOCATIONS AND INVERT ELEVATIONS.

SMALL CONTROL STRUCTURE
N.T.S.

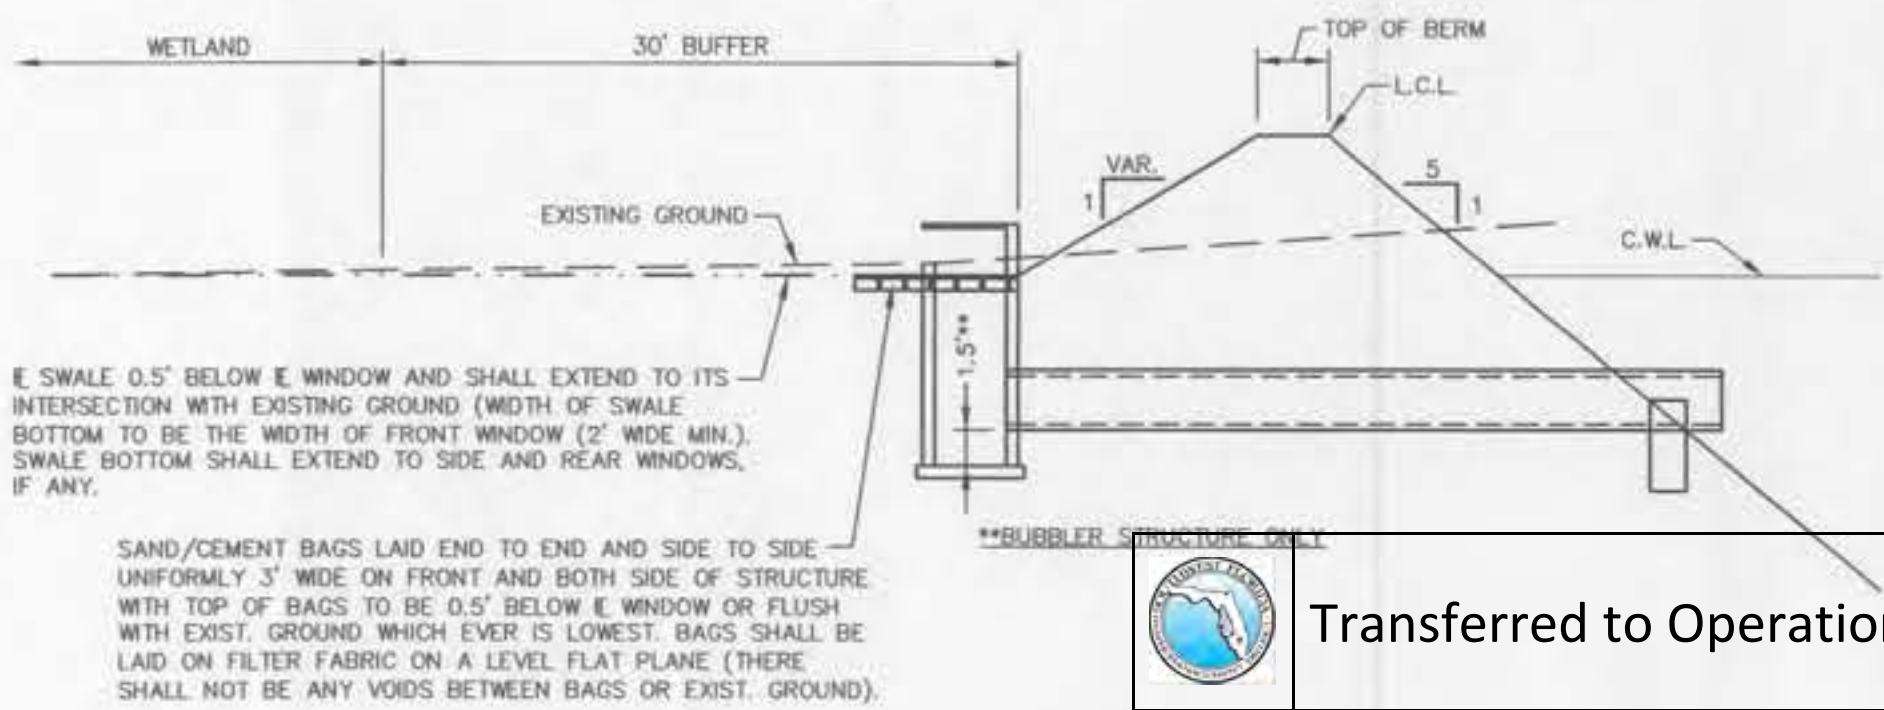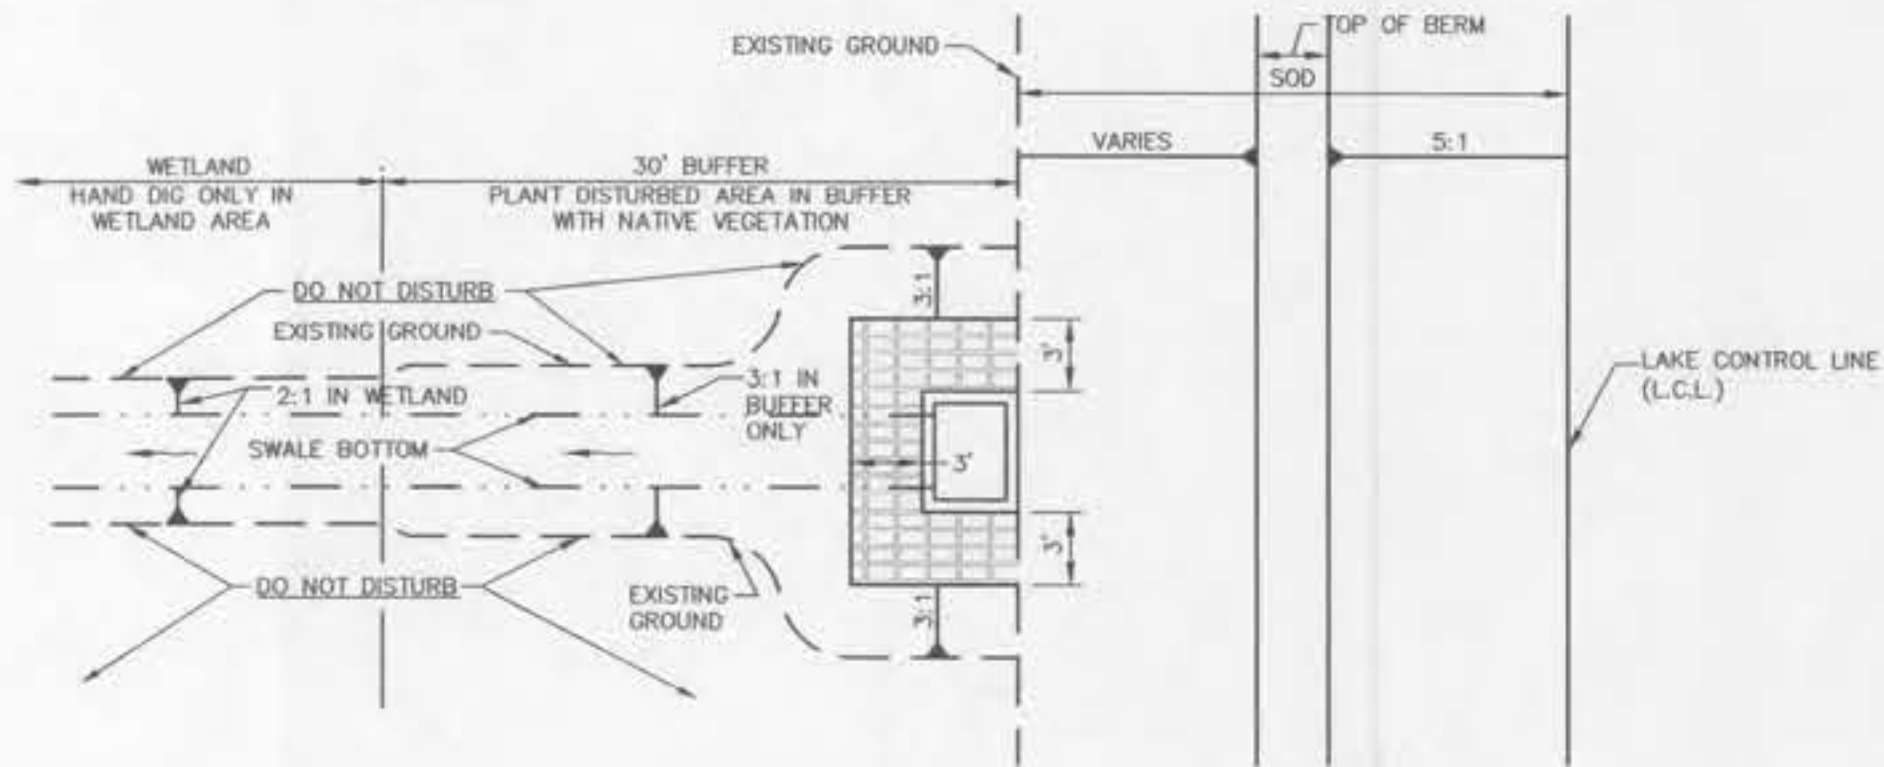

CONTROL STRUCTURE WHEN LOCATED AT WETLAND

NOTE: CONSTRUCTION IN WETLANDS SHOULD BE ACCESSED FROM THE UPLAND SIDE. ANY TEMPORARY IMPACT AREAS IN THE WETLAND SHOULD BE REGRADED AND RESTORED TO THEIR NATURAL CONDITION. CONSTRUCTION LIMITS IN WETLAND SHOULD NOT EXTEND MORE THAN 10 FEET FROM THE EDGE OF THE STRUCTURE UNLESS WETLAND SWALE IS REQUIRED.

Southwest Florida
Water Management District

OCT 28 2016

Received
Sarasota RSB

Imaged As Is

Kimley»Horn

© 2016 KIMLEY-HORN AND ASSOCIATES, INC.
1777 MAIN STREET, SUITE 200, SARASOTA, FL 34236
PHONE: 941-378-7800
WWW.KIMLEY-HORN.COM CA 00000696

LICENSED PROFESSIONAL

THOMAS M. STOVALL

FLORIDA LICENSE NUMBER
41224

KHA PROJECT
048119072

DATE
DEC. 2014

SCALE
AS SHOWN

DESIGNED BY
KHA


DRAWN BY
RBK

CHECKED BY
TMS

RECORD DRAWING
MODIFIED CONTROL
STRUCTURE CS-W-L

GRAND PALM PHASE 3A
(FKA GRAND PALM PHASE 1D)
PREPARED FOR
RESOURCE CONSERVATION OF
SARASOTA, LLC
FLORIDA
SARASOTA COUNTY

SHEET NUMBER
B-15

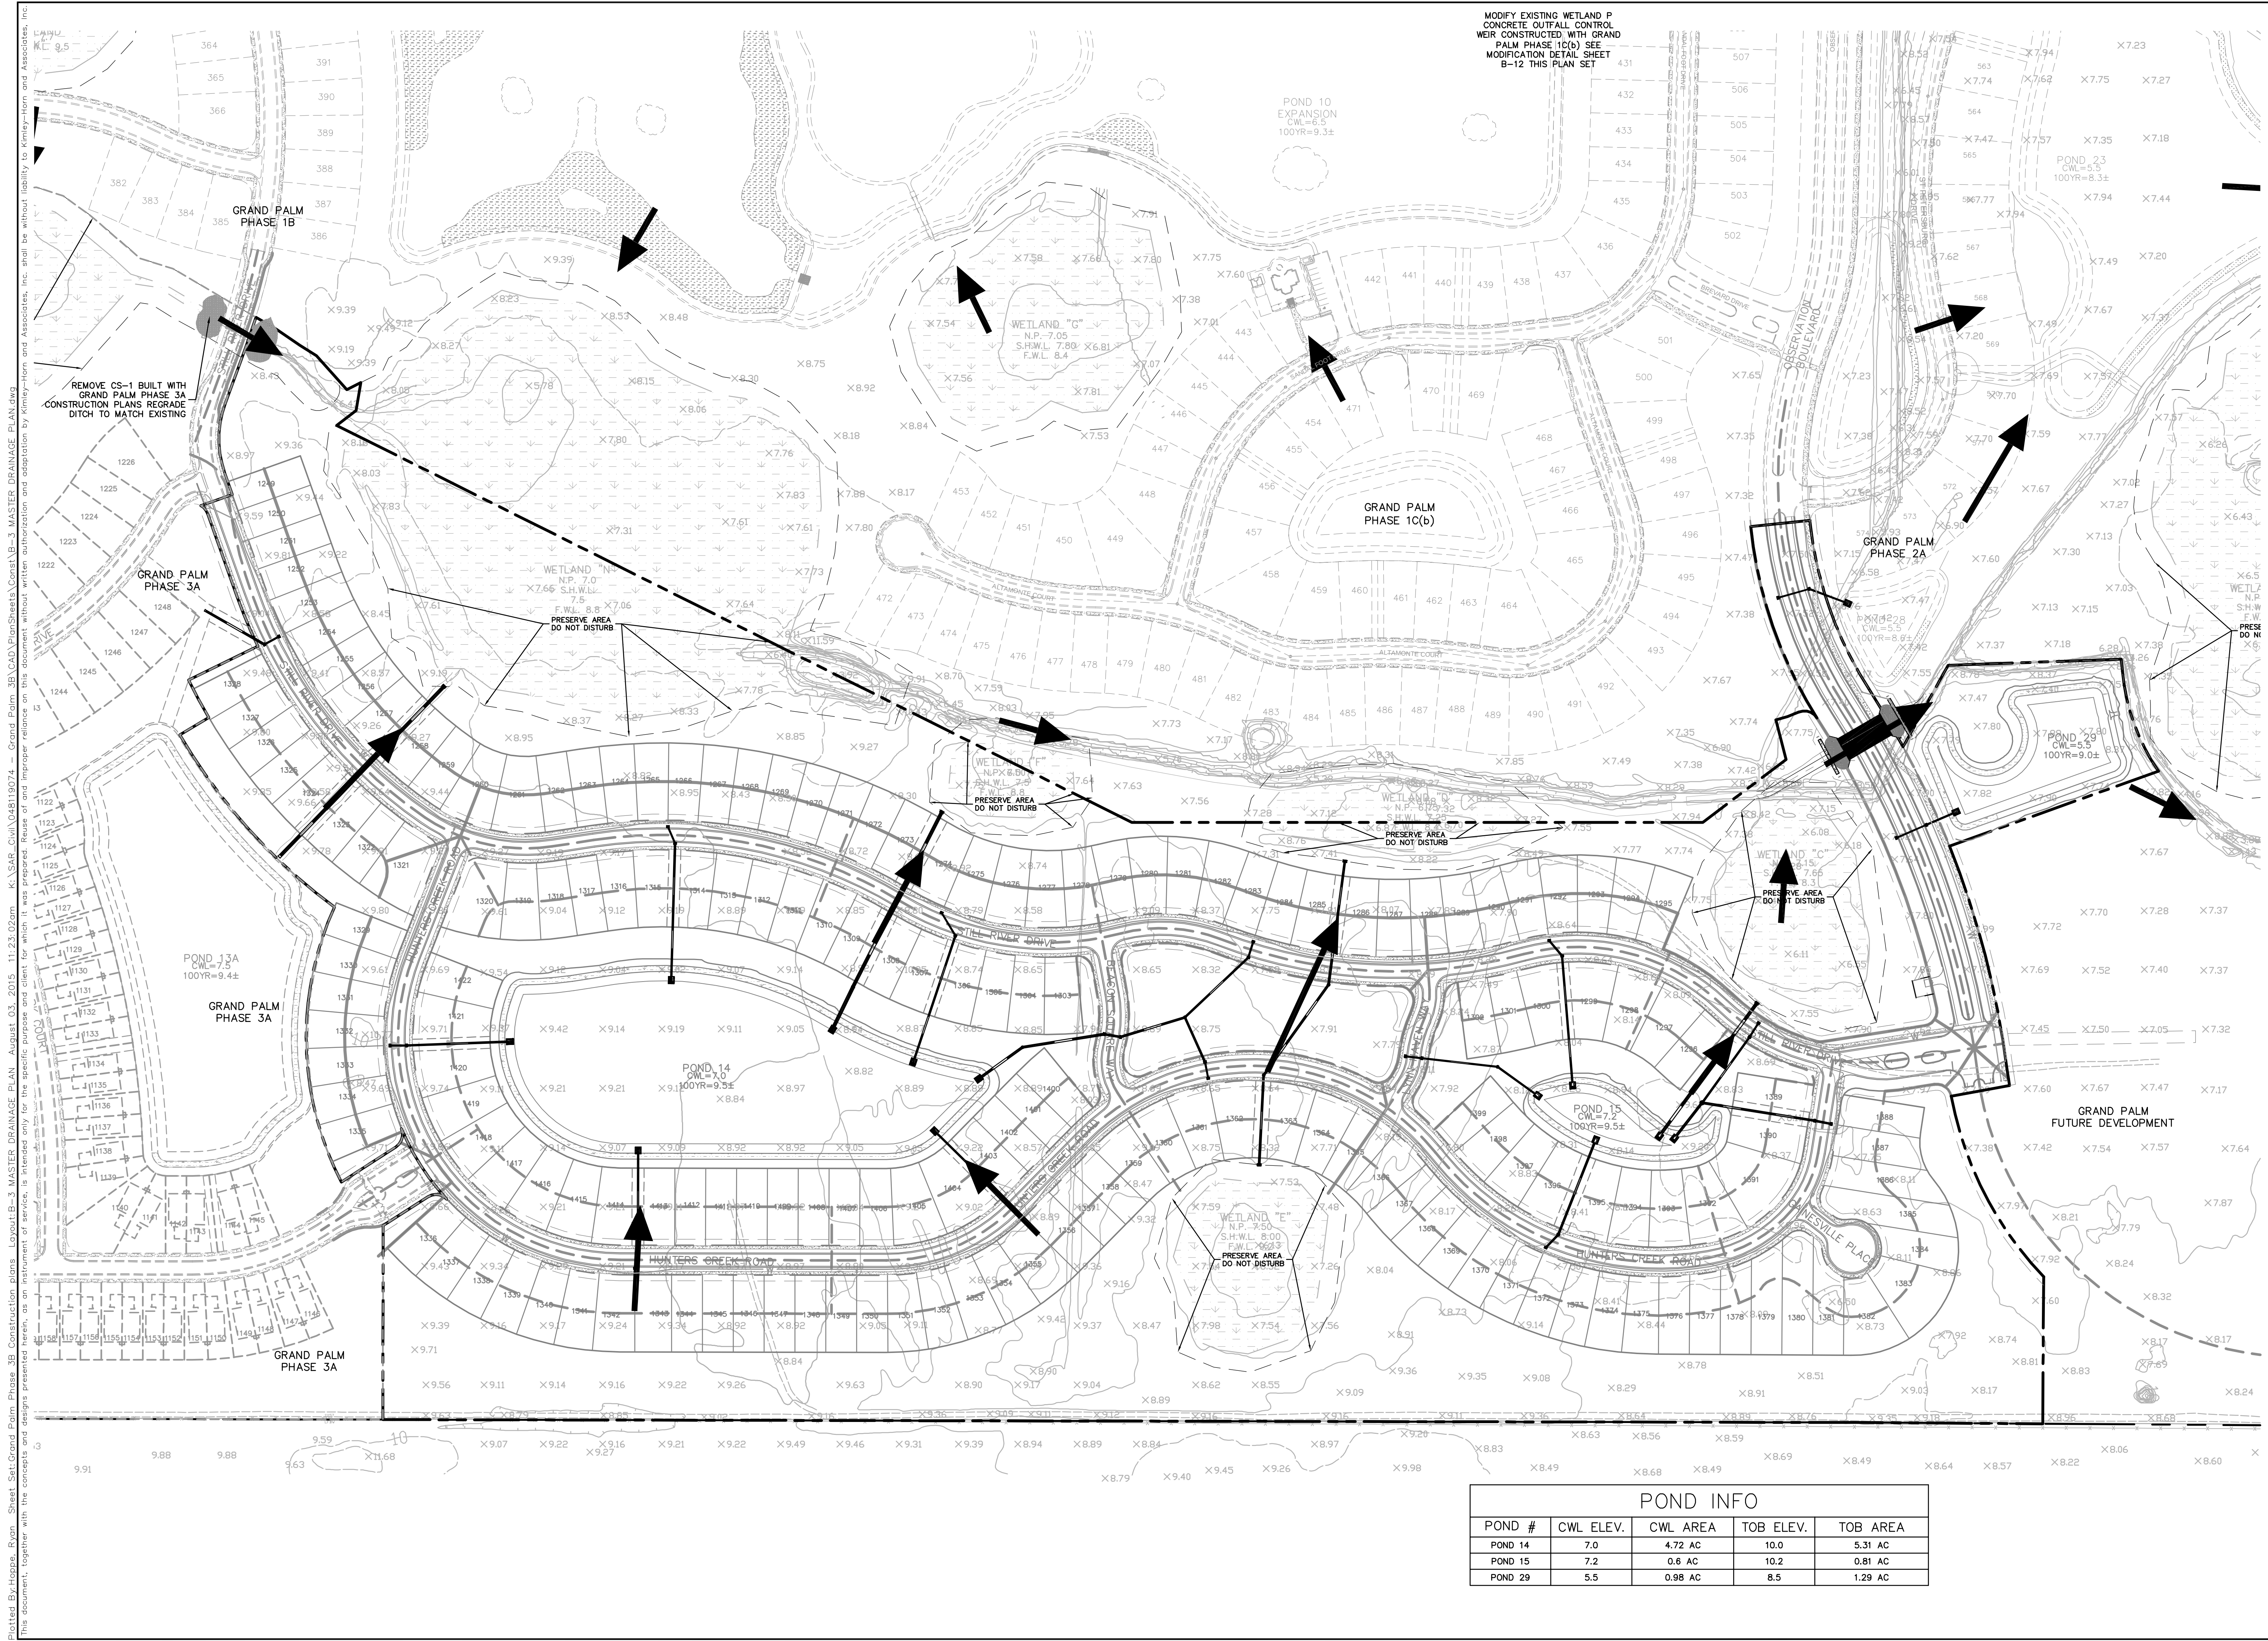

POND INFO				
POND #	CWL ELEV.	CWL AREA	TOB ELEV.	TOB AREA
POND 14	7.0	4.72 AC	10.0	5.31 AC
POND 15	7.2	0.6 AC	10.2	0.81 AC
POND 29	5.5	0.98 AC	8.5	1.29 AC

Plotted By: Hopper, Ryan - Sheet Set: Grand Palm Phase 3B Construction Plans - Lovett: B-3 MASTER DRAINAGE PLAN - August 03, 2015 11:23:02am - K:\SAR-Civil\048119074 - Grand Palm 3B\CD\PlanSheets\Const-B-3 MASTER DRAINAGE PLAN.dwg
This document, together with the concepts and designs presented herein, is intended only for the specific purpose and client for which it was prepared. Reuse of this document without written authorization and adaptation by Kimley-Horn and Associates, Inc. shall be without liability to Kimley-Horn and Associates, Inc.

GRAND PALM PHASE 3B
PREPARED FOR
RESOURCE CONSERVATION OF
SARASOTA, LLC

FLORIDA
SARASOTA COUNTY

MASTER DRAINAGE
PLAN

LICENSED PROFESSIONAL
THOMAS M. STOVALL
DATE
APRIL 2015
SCALE
AS SHOWN
DESIGNED BY
RBK
DRAWN BY
RBK
CHECKED BY
TMS



DATE: _____

Kimley»Horn

© 2015 KIMLEY-HORN AND ASSOCIATES, INC.
1777 MAIN STREET, SUITE 200, SARASOTA, FL 34236
PHONE: 941-379-7600
WWW.KIMLEY-HORN.COM CA 00000696


REVISIONS

No.	DATE	BY

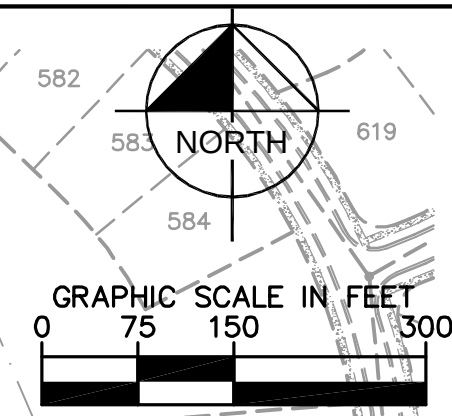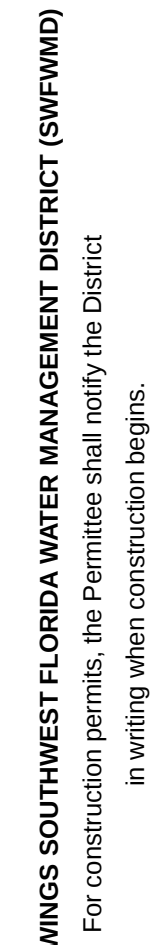

SHEET NUMBER B-4	GRAND PALM PHASE 3B PREPARED FOR RESOURCE CONSERVATION OF SARASOTA, LLC SARASOTA COUNTY FLORIDA	PAVING GRADING AND DRAINAGE INDEX	KHA PROJECT 048119074	LICENSED PROFESSIONAL	 © 2015 KIMLEY-HORN AND ASSOCIATES, INC. 1777 MAIN STREET, SUITE 200, SARASOTA, FL 34236 PHONE: 941-379-7600 WWW.KIMLEY-HORN.COM CA 00000696	No.	REVISIONS	DATE	BY	
			DATE APRIL 2015	THOMAS M. STOVALL						FLORIDA LICENSE NUMBER 41224
			SCALE AS SHOWN							
			DESIGNED BY RBK							
			DRAWN BY RBK							
			CHECKED BY TMS	DATE: --- -- --						

INAGE PLAN.dwg

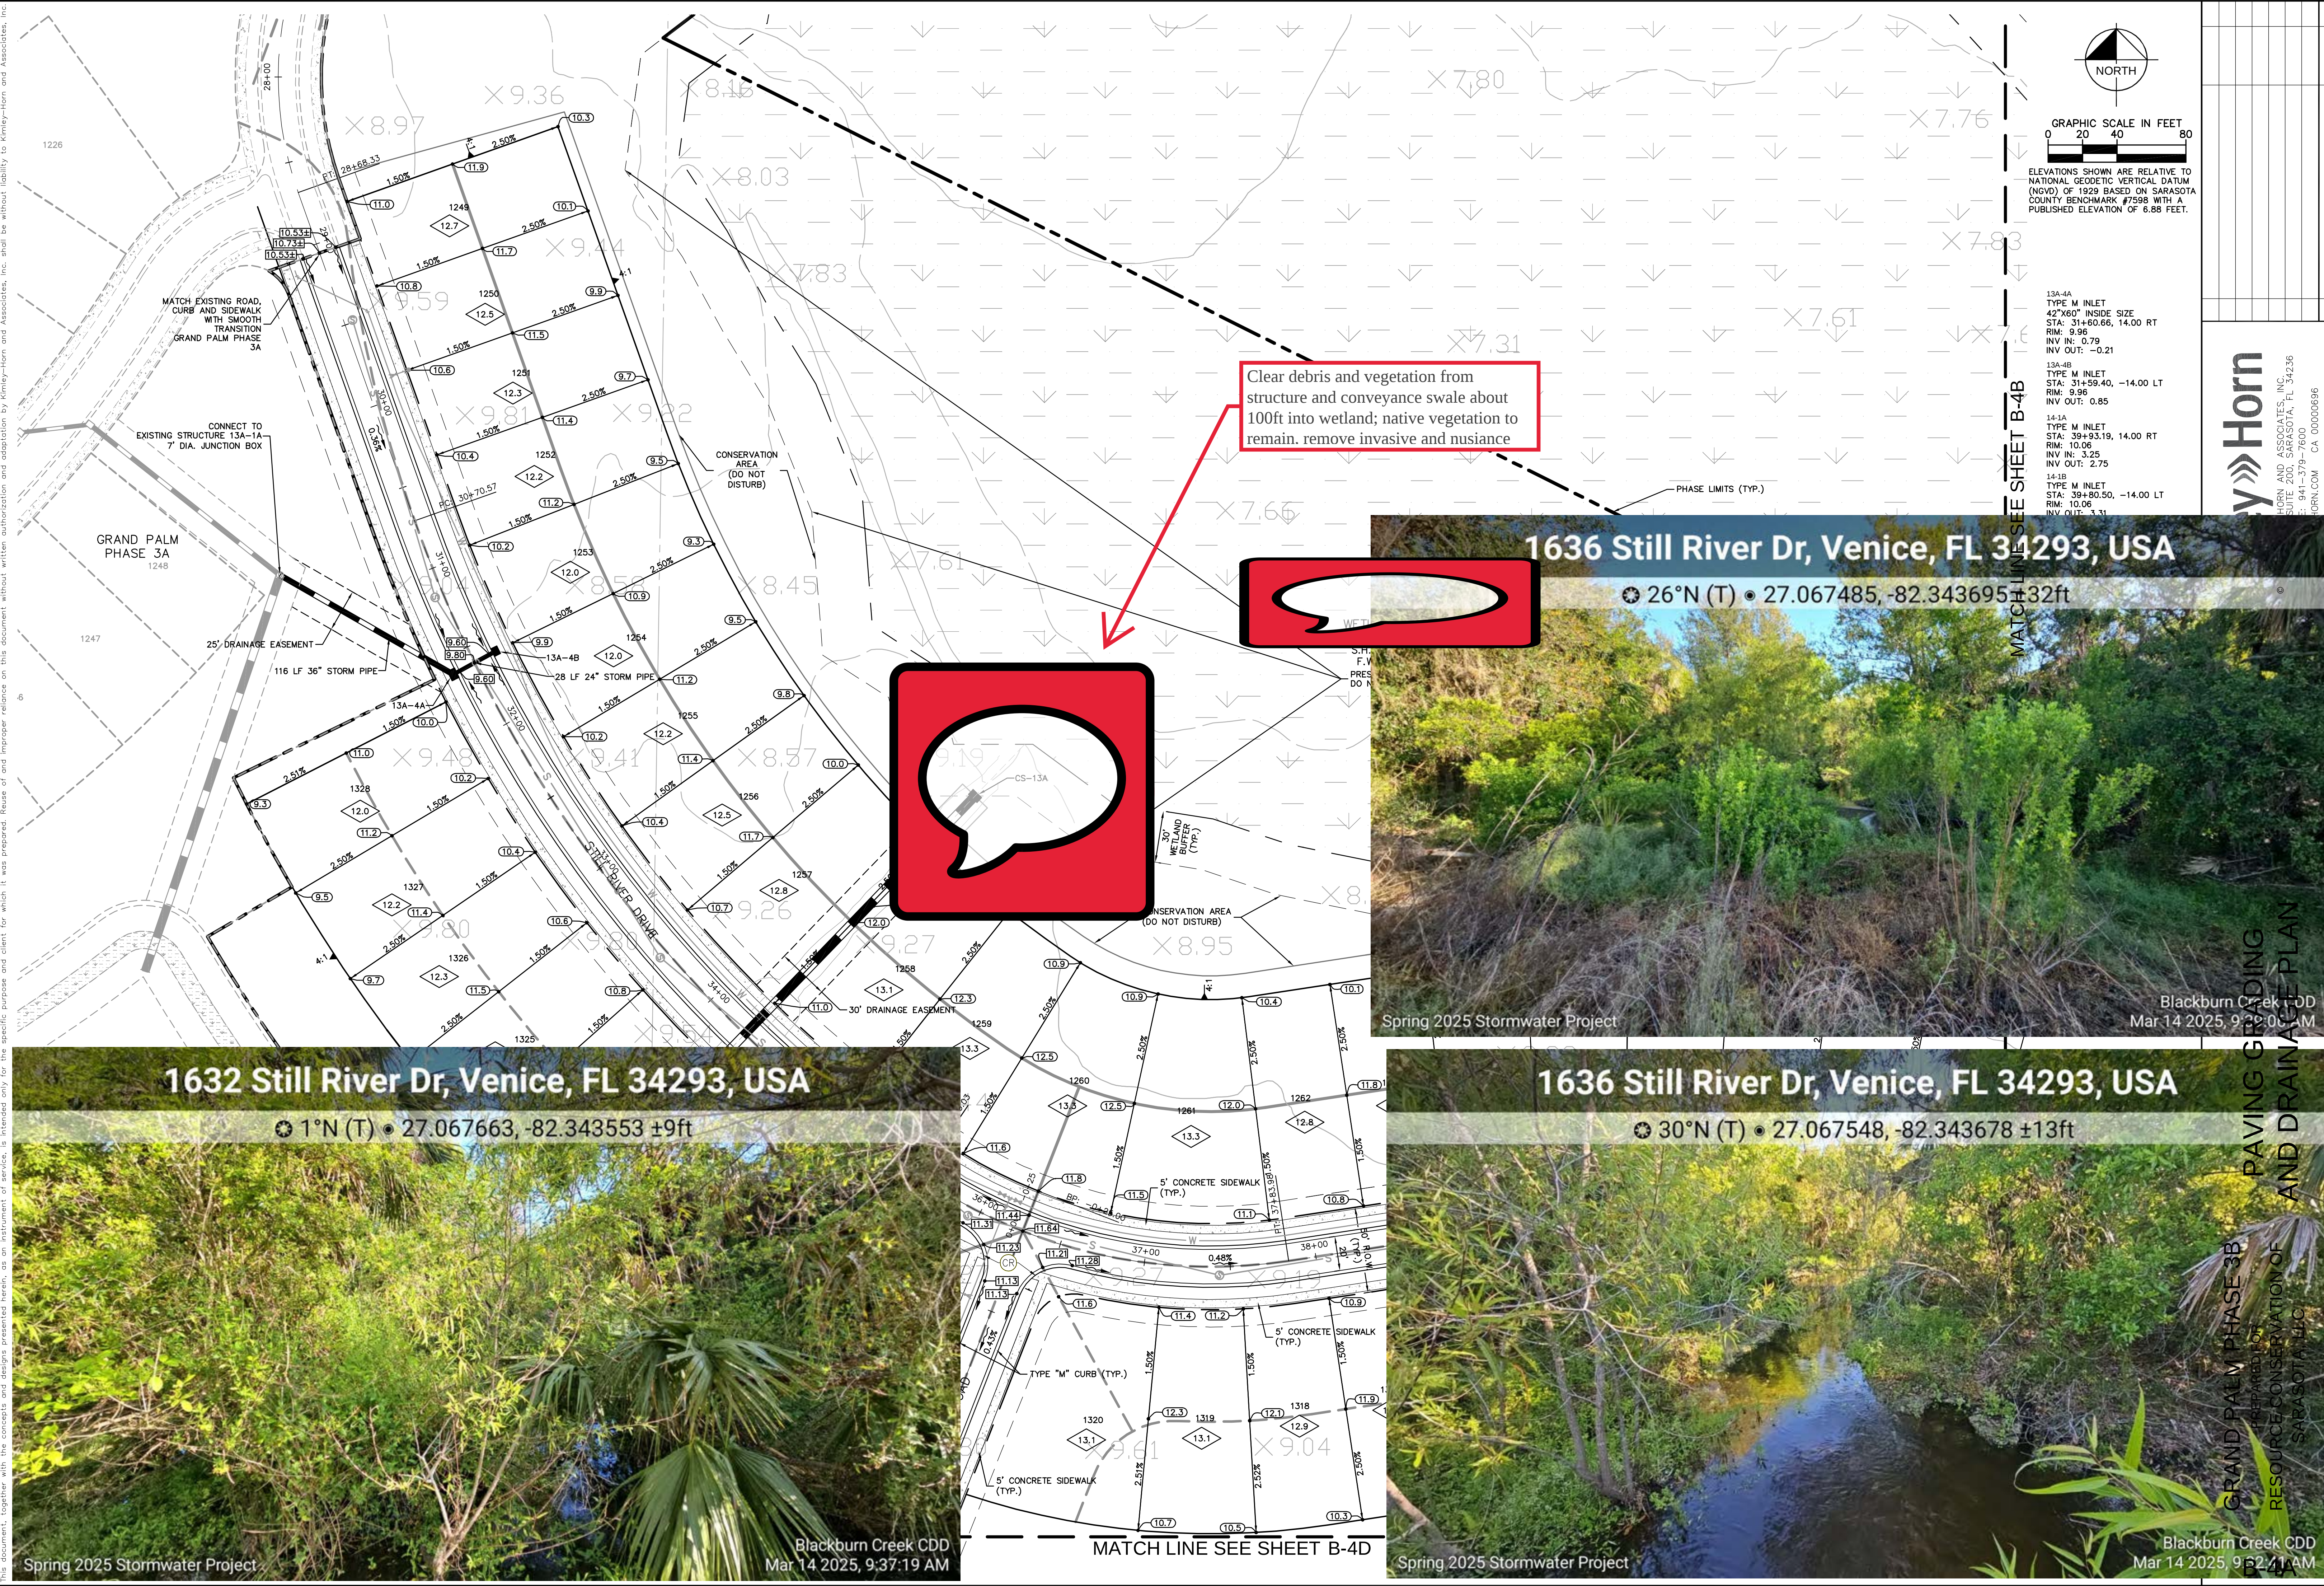

y»»Horn
HORN AND ASSOCIATES, INC.
SUITE 200, SARASOTA, FL 34236
: 941-379-7600
HORN.COM CA 00000696

27°N (T) 27.066956, -82.341091 ±16ft

☼ 247°SW (T) ☉ 27.067145, -82.340841 ±9ft

GRAPHIC SCALE IN FEET

0 20 40 80

ELEVATIONS SHOWN ARE RELATIVE TO NATIONAL GEODETIC VERTICAL DATUM (NGVD) OF 1929 BASED ON SARASOTA COUNTY BENCHMARK #7598 WITH A PUBLISHED ELEVATION OF 6.88 FEET.

E-18
4' DIA. JUNCTION BOX
STA: 51+42.32, 30.00 RT
RM: 10.06
INV IN: 1.26
INV OUT: 1.26
14-3A
TYPE M INLET
STA: 45+00.26, 14.00 RT
RM: 10.06
INV IN: 0.98
INV OUT: 0.48
14-3B
TYPE M INLET
STA: 44+65.03, -14.00 LT
RM: 10.06
INV OUT: 1.07
14-4E
TYPE M INLET
STA: 50+03.97, 14.00 RT
RM: 10.06
INV IN: 3.53
INV OUT: 3.03
14-4F
TYPE M INLET
STA: 50+03.97, -14.00 LT
RM: 10.06
INV OUT: 3.59


GRAND PALM PHASE 3B
PREPARED FOR
RESOURCE CONSERVATION OF
SARASOTA, LLC
SARASOTA COUNTY
FLORIDA

SHEET NUMBER
B-4B

Plotted By: Hoppe, Ryan Sheet Set: Grand Palm Phase 3B Construction plans Layout: B-4B PAVING GRADING AND DRAINAGE PLAN August 03, 2015 11:26:32am K:\S\Civil\048119074 - Grand Palm 3B\CAD\PlanSheets



MATCH LINE SEE SHEET B-4B

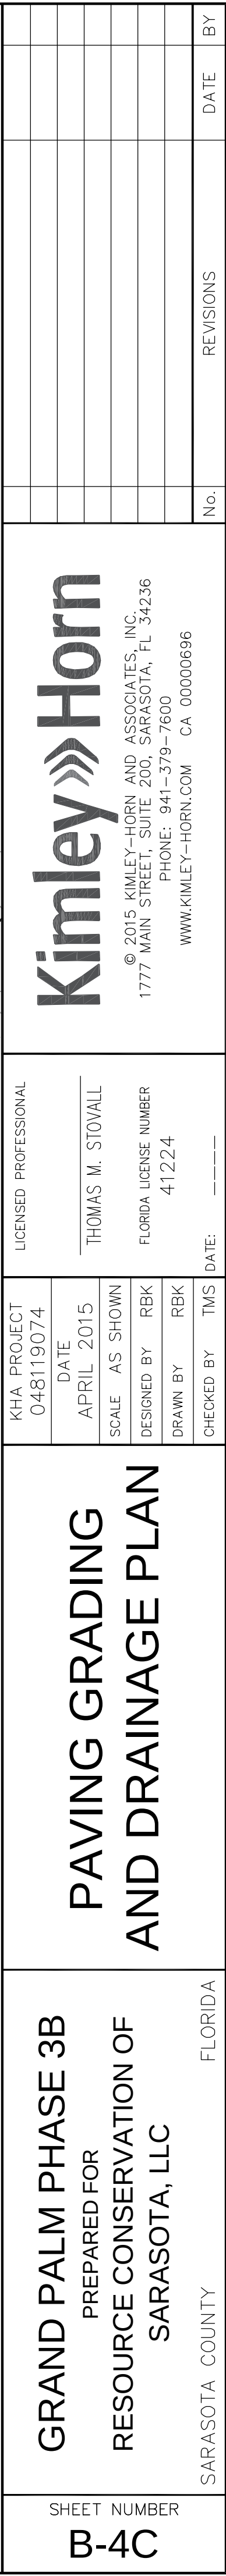

© 2015 KIMLEY-HORN AND ASSOCIATES, INC.
1777 MAIN STREET, SUITE 200, SARASOTA, FL 34236
PHONE: 941-379-7600




•
•
SCALE	AS SHOWN
-------	----------

RAWN BI	KDK
CHECKED BY	TMS

FLORIDA
SALVASTOIA, LLC
RASOTA COUNTY

SHEET NUMBER
B-4C

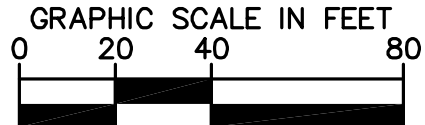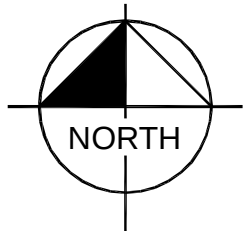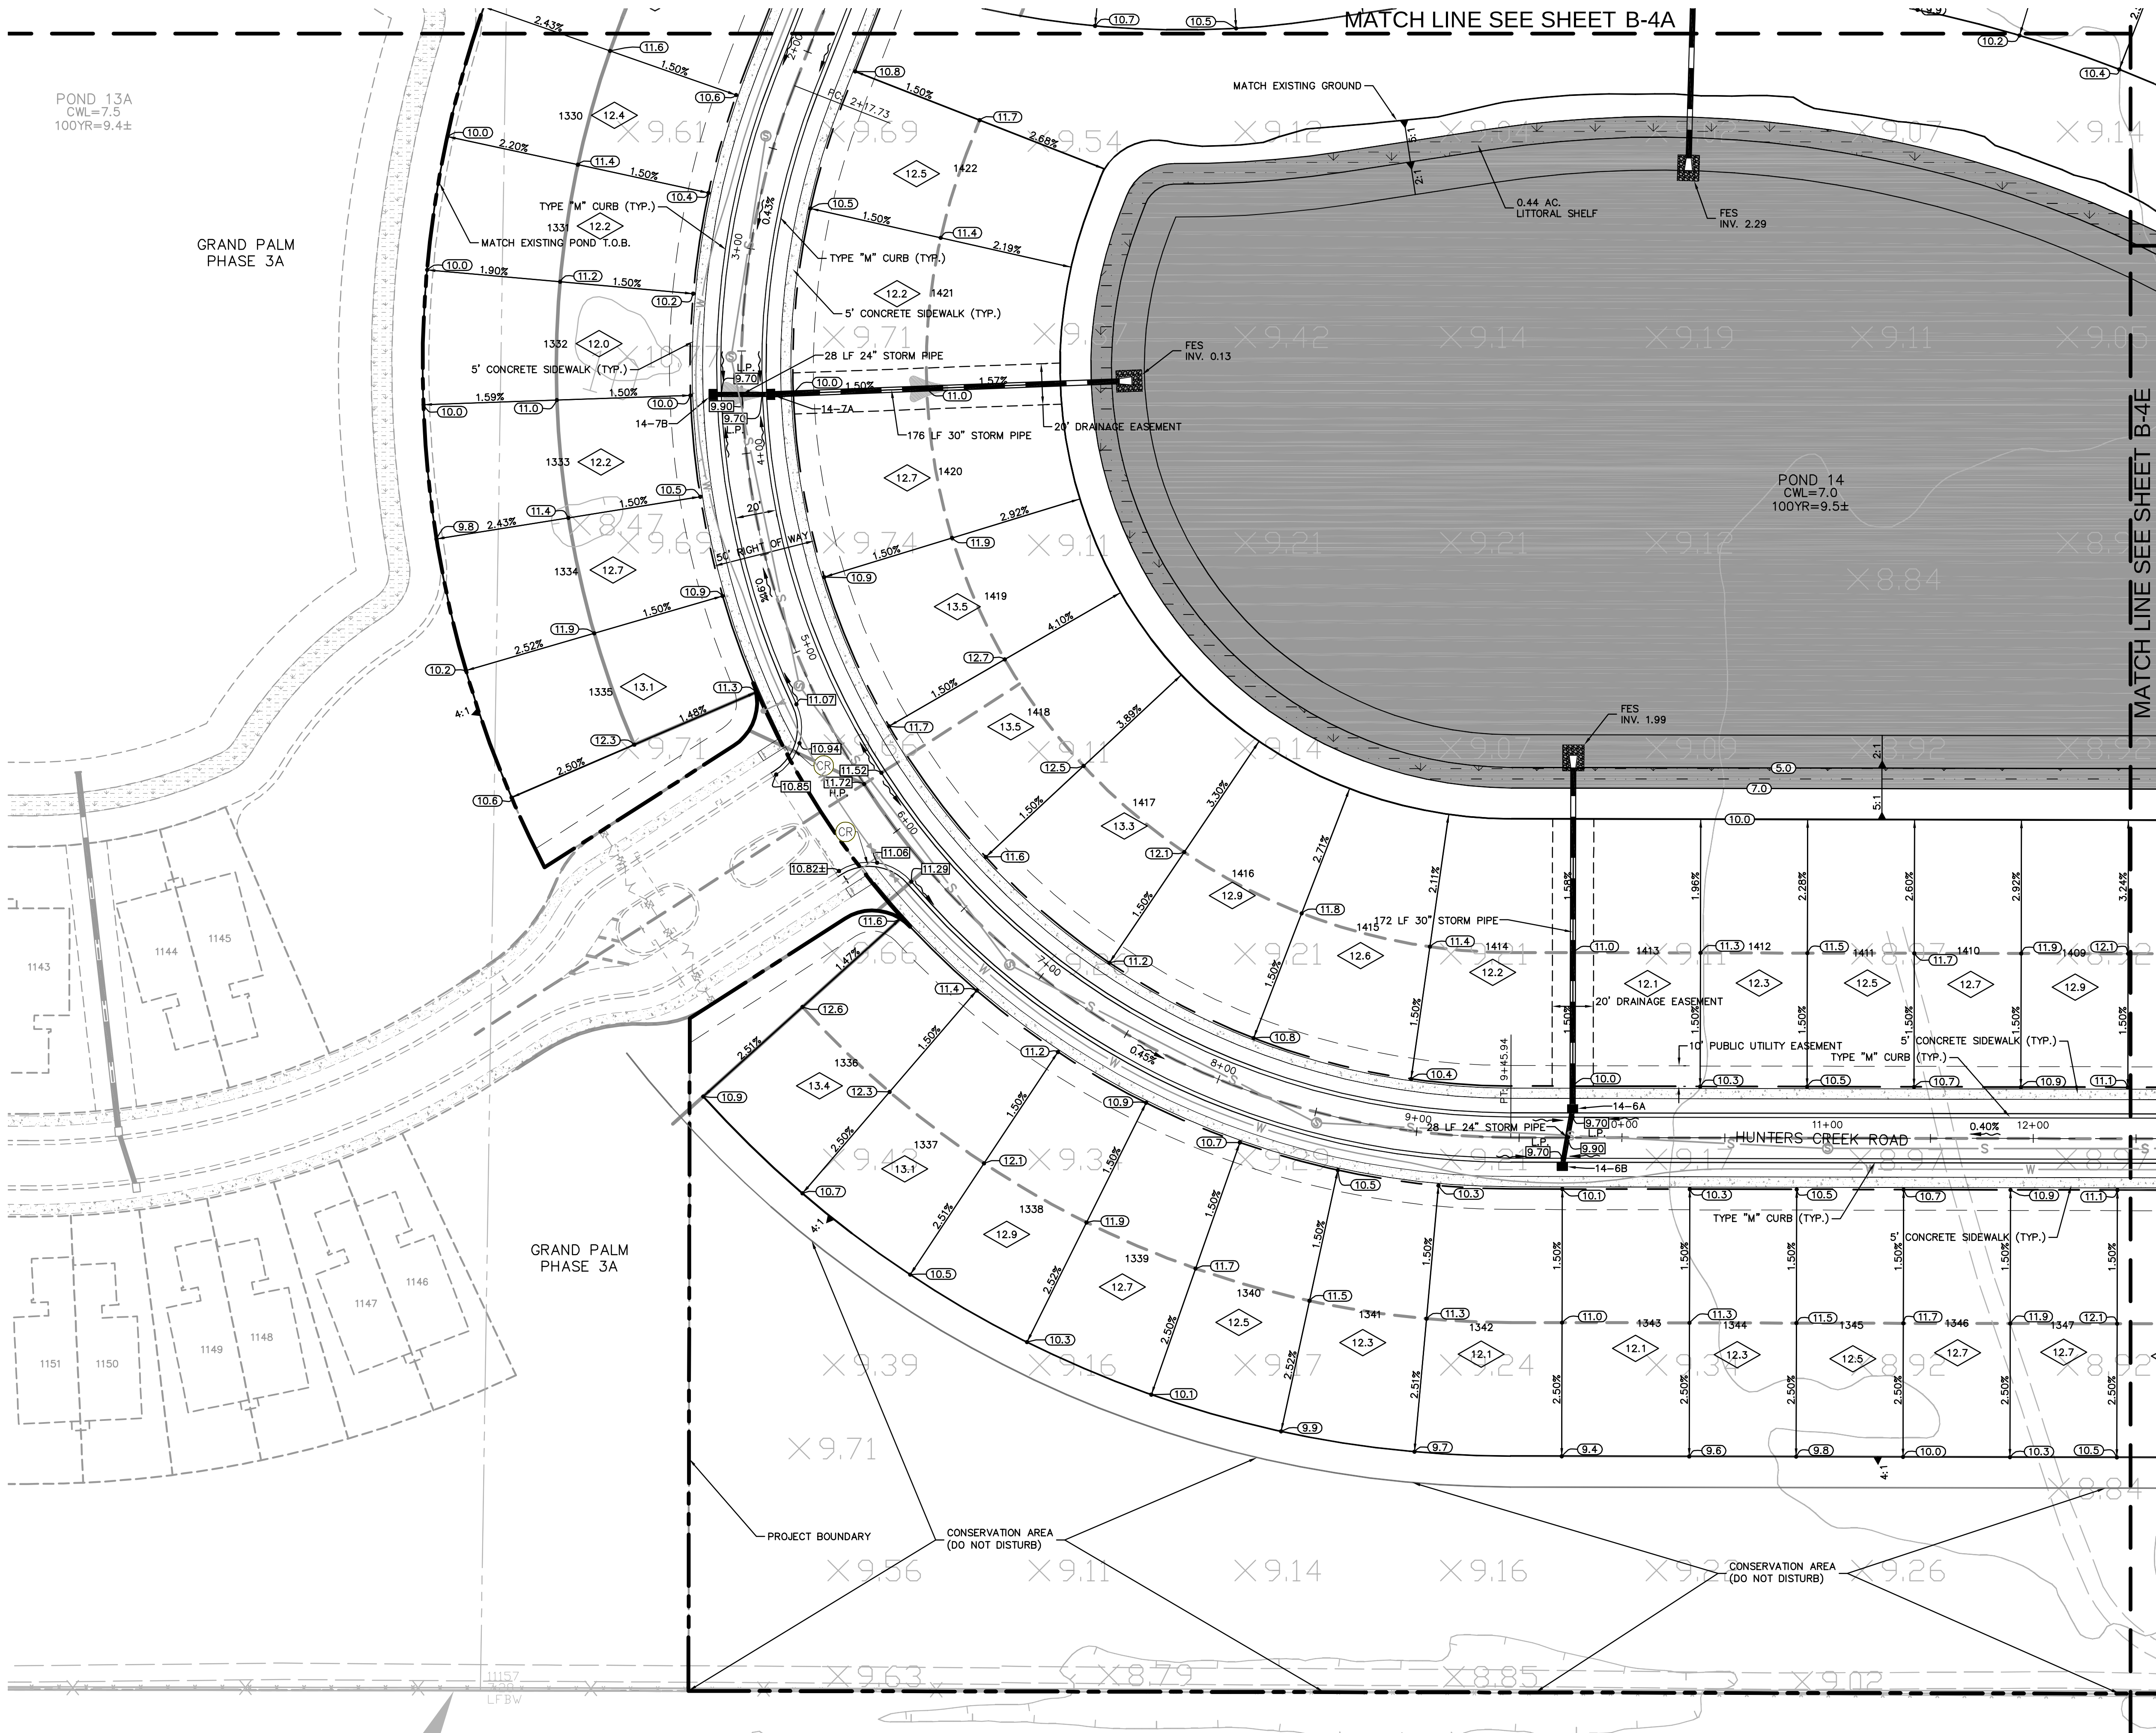

ELEVATIONS SHOWN ARE RELATIVE TO
NATIONAL GEODEIC VERTICAL DATUM
(NGVD) OF 1929 BASED ON SARASOTA
COUNTY BENCHMARK #7598 WITH A
PUBLISHED ELEVATION OF 6.88 FEET.

LEGEND

- EXISTING MAJOR CONTOUR LINE
- EXISTING MINOR CONTOUR LINE
- MINOR BASIN LINE
- MAJOR BASIN LINE
- PROJECT BOUNDARY
- JURISDICTIONAL WETLAND LINE
- WETLAND BUFFER LINE

WETLAND TO BE PRESERVED

- EXISTING SPOT ELEVATION
- PROPOSED PAVED SPOT ELEVATION
- PROPOSED NON PAVED ELEVATION
- SLOPE DIRECTION
- FINISH FLOOR ELEVATION
- CURB RAMP (PER FDOT INDEX #304)

NOTES:

- FINISHED PAD GRADE TO BE 10" BELOW FINISHED FLOOR ELEVATION
- STORM PIPING SHALL BE AS FOLLOWS:
RCP CLASS III PER ASTM C-76
CORRUGATED HDPE PIPE PER AASHTO M-294
PVC PIPE PER ASTM F949
- JOINTS SHALL BE WATER TIGHT
- STORM PIPE MATERIAL MUST BE APPROVED BY SARASOTA COUNTY.
- CONTRACTOR SHALL SELECT THE MOST ECONOMICAL PRODUCT.

REQUIRED LITTORAL ZONE VEGETATION SHALL BE MAINTAINED IN PERPETUITY.
A MONITORING AND MAINTENANCE BOND NEEDS TO BE SUBMITTED TO SARASOTA
ENVIRONMENTAL PROTECTION DIVISION TO COVER 100% OF THE COST FOR TWO
YEARS OF MONITORING AND MAINTENANCE OF THE LITTORAL ZONES PRIOR TO
EXCAVATION PURSUANT TO LOR ENVIRONMENTAL TECHNICAL MANUAL SECTION
A.5. THIS BOND SHALL REMAIN IN EFFECT UNTIL THE LITTORAL ZONES ARE
DETERMINED SUCCESSFUL BY RPS.

14-6A
TYPE M INLET
STA: 9+75.98, -14.00 LT
RIM: 10.06
INV IN: 5.39
INV OUT: 4.89

14-6B
TYPE M INLET
STA: 9+71.04, 14.00 RT
RIM: 10.06
INV IN: 5.39
INV OUT: 5.44

14-7A
TYPE M INLET
STA: 3+71.65, -14.00 LT
RIM: 10.06
INV IN: 0.98
INV OUT: 0.48


14-7B
TYPE M INLET
STA: 3+70.74, 14.00 RT
RIM: 10.06
INV IN: 0.98
INV OUT: 1.04

KHA PROJECT 048119074		DATE APRIL 2015		SCALE AS SHOWN		DESIGNED BY RBK		DRAWN BY RBK		CHECKED BY TMS		DATE -----	
GRAND PALM PHASE 3B PREPARED FOR RESOURCE CONSERVATION OF SARASOTA, LLC				PAVING GRADING AND DRAINAGE PLAN				FLORIDA SARASOTA COUNTY				BY DATE	
SHEET NUMBER B-4D												REVISIONS No.	

© 2015 KIMLEY-HORN AND ASSOCIATES, INC.
1777 MAIN STREET, SUITE 200, SARASOTA, FL 34236
PHONE: 941-379-7600
WWW.KIMLEY-HORN.COM CA 00000696

MATCH LINE SEE SHEET B-4D



MATCH LINE SEE SHEET B-4B

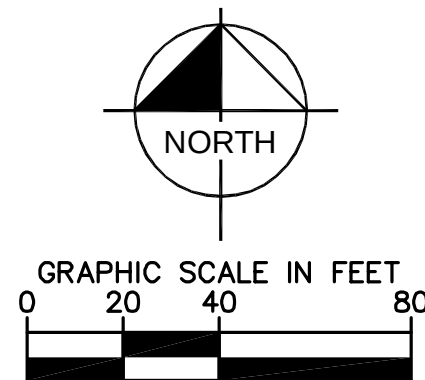

REQUIRED LITTORAL ZONE VEGETATION SHALL BE MAINTAINED IN PERPETUITY.

A MONITORING AND MAINTENANCE BOND NEEDS TO BE SUBMITTED TO SARASOTA ENVIRONMENTAL PROTECTION DIVISION TO COVER 100% OF THE COST FOR TWO YEARS OF MONITORING AND MAINTENANCE OF THE LITTORAL ZONES PRIOR TO EXCAVATION PURSUANT TO LDR ENVIRONMENTAL TECHNICAL MANUAL SECTION A.5. THIS BOND SHALL REMAIN IN EFFECT UNTIL THE LITTORAL ZONES ARE DETERMINED SUCCESSFUL BY RPS.

ELEVATIONS SHOWN ARE RELATIVE TO NATIONAL GEODETIC VERTICAL DATUM (NGVD) OF 1929 BASED ON SARASOTA COUNTY BENCHMARK #7598 WITH A PUBLISHED ELEVATION OF 6.88 FEET.

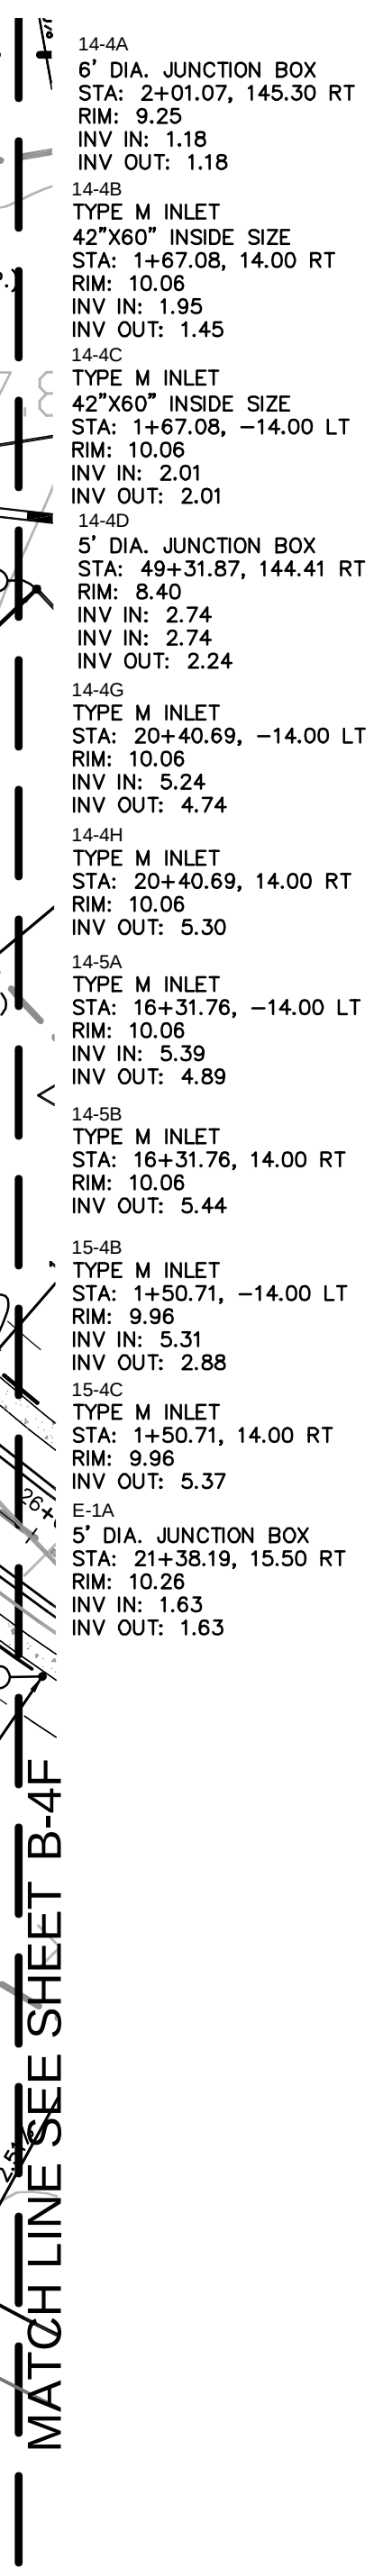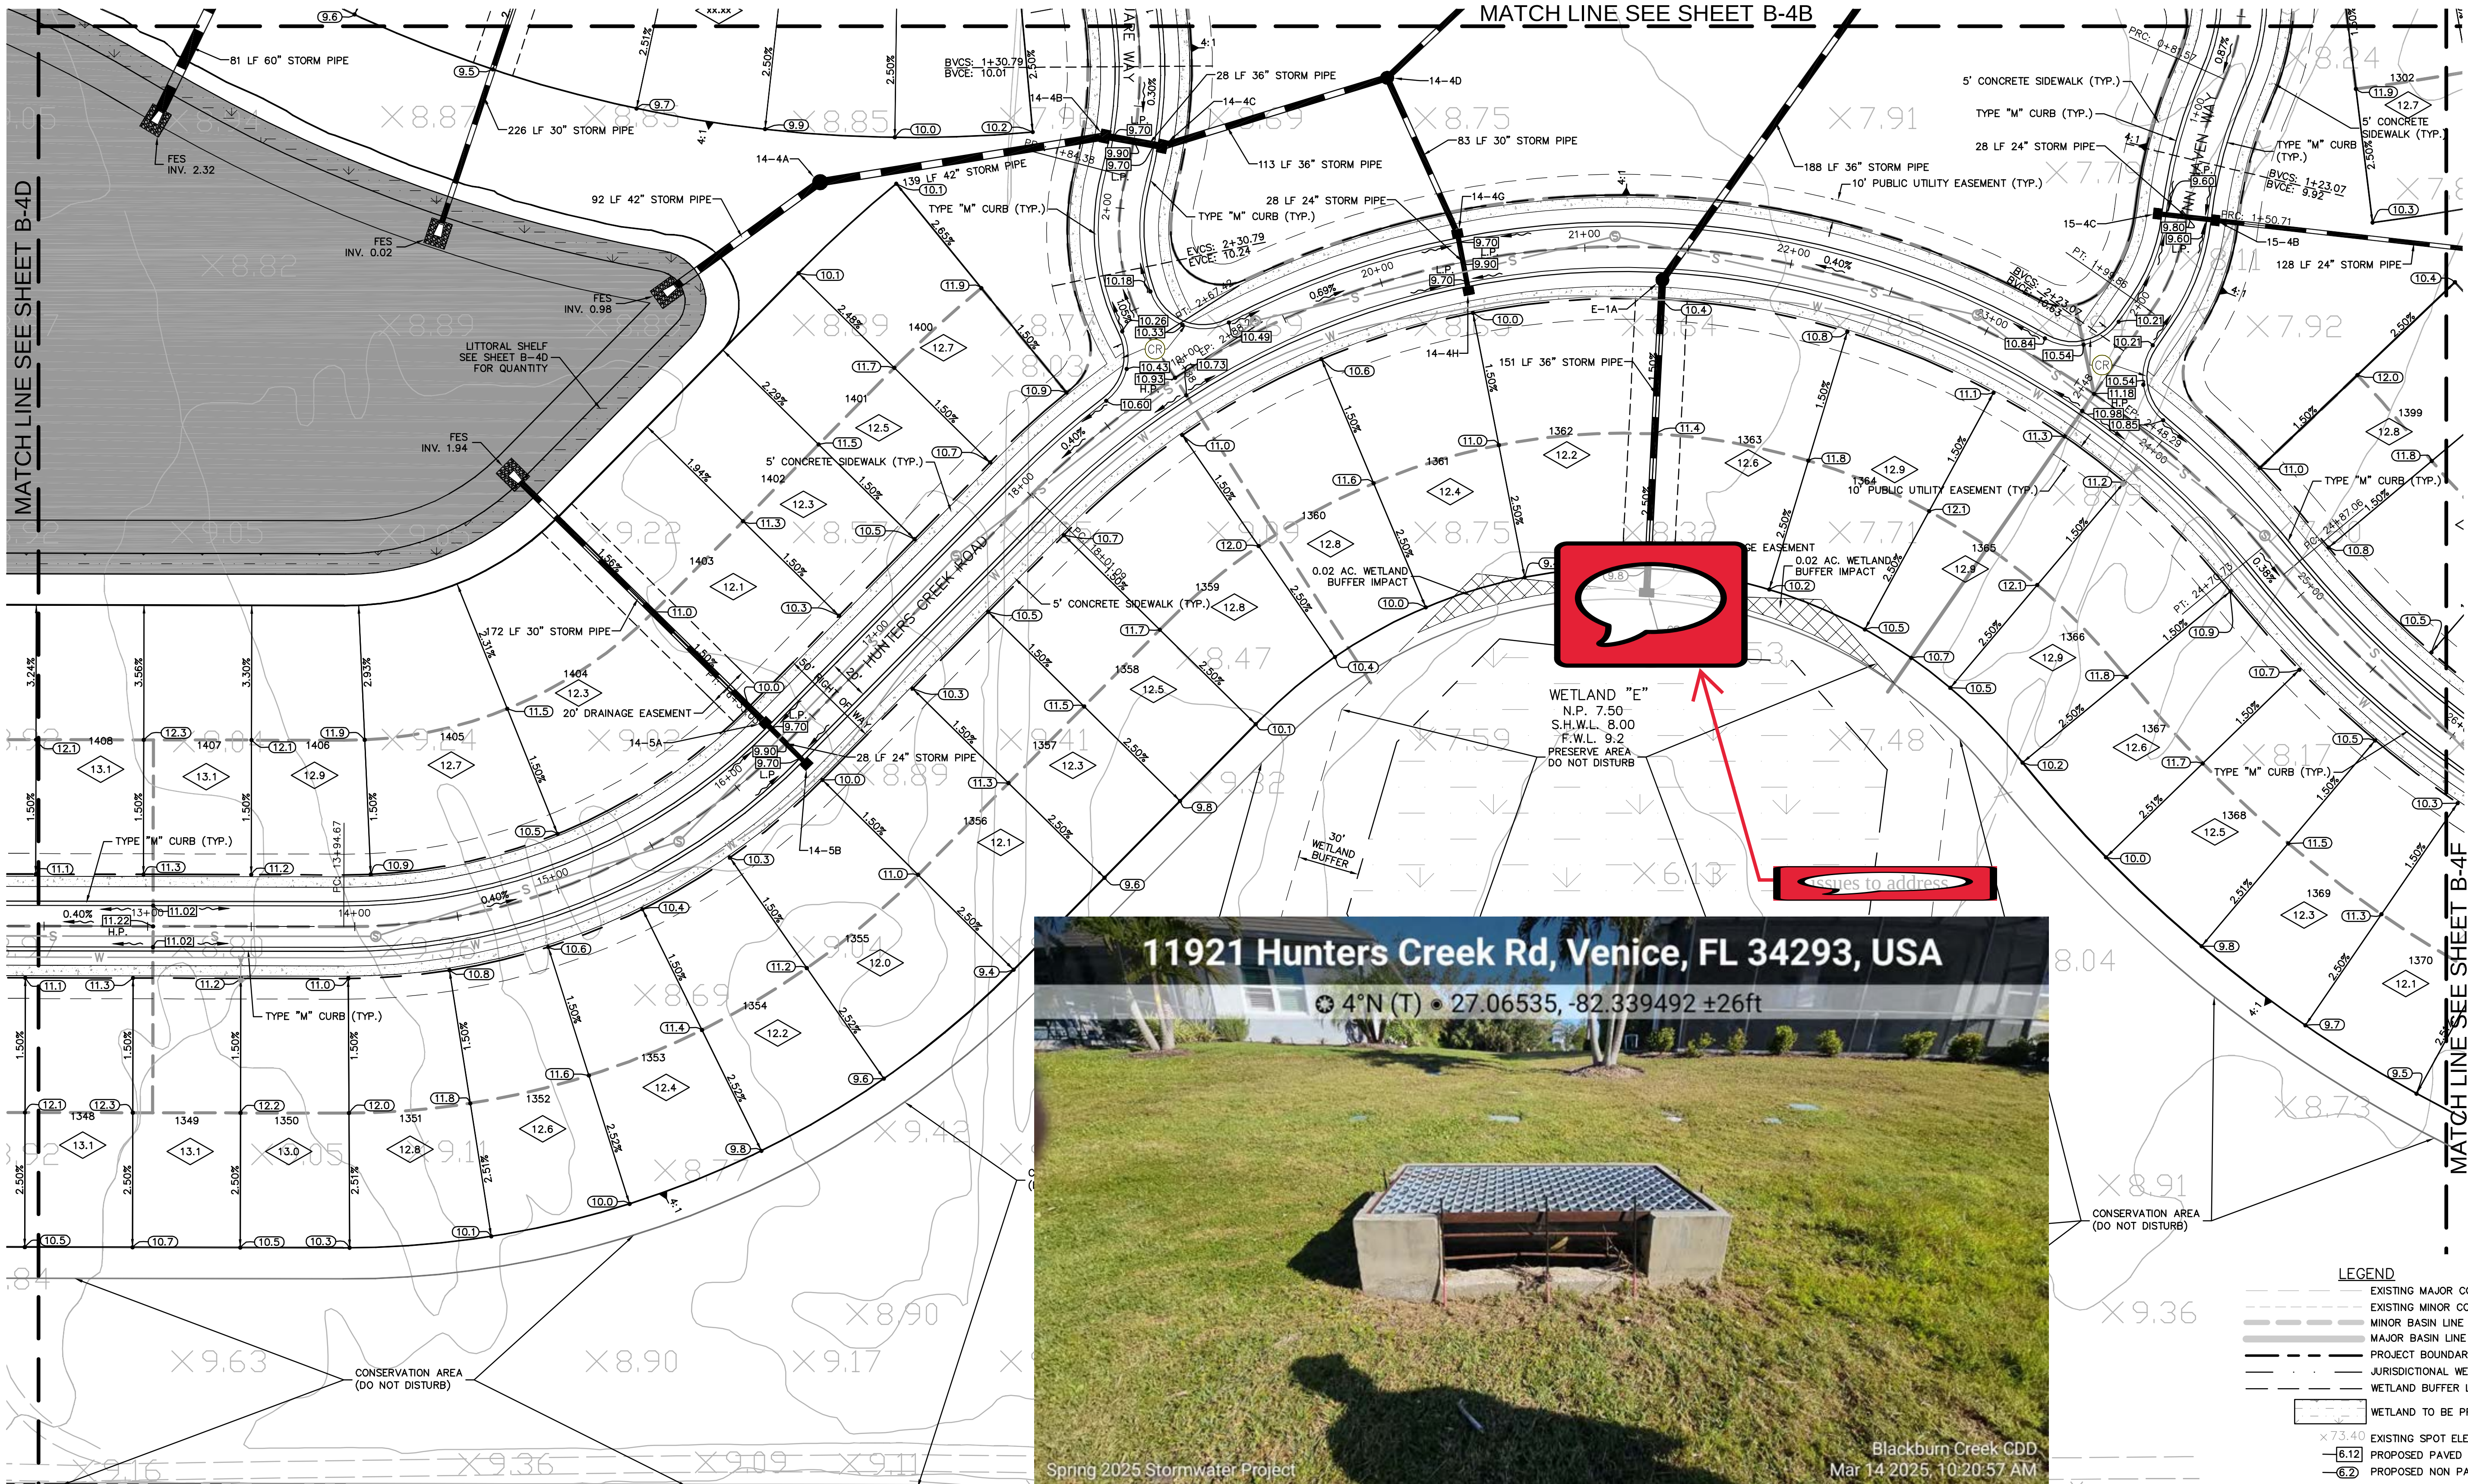


LEGEND


- EXISTING MAJOR CONTOUR LINE
- EXISTING MINOR CONTOUR LINE
- MINOR BASIN LINE
- MAJOR BASIN LINE
- PROJECT BOUNDARY
- JURISDICTIONAL WETLAND LINE
- WETLAND BUFFER LINE
- WETLAND TO BE PRESERVED
- EXISTING SPOT ELEVATION
- PROPOSED PAVED SPOT ELEVATION
- PROPOSED NON PAVED ELEVATION
- SLOPE DIRECTION
- FINISH FLOOR ELEVATION
- CURB RAMP (PER FDOT INDEX #304)

NOTES:

- FINISHED PAD GRADE TO BE 10" BELOW FINISHED FLOOR ELEVATION
- STORM PIPING SHALL BE AS FOLLOWS:
RCP CLASS III PER ASTM C-76
CORRUGATED HDPE PIPE PER AASHTO M-294
PVC PIPE PER ASTM F849
JOINTS SHALL BE WATER TIGHT
- STORM PIPE MATERIAL MUST BE APPROVED BY SARASOTA COUNTY.
- CONTRACTOR SHALL SELECT THE MOST ECONOMICAL PRODUCT.

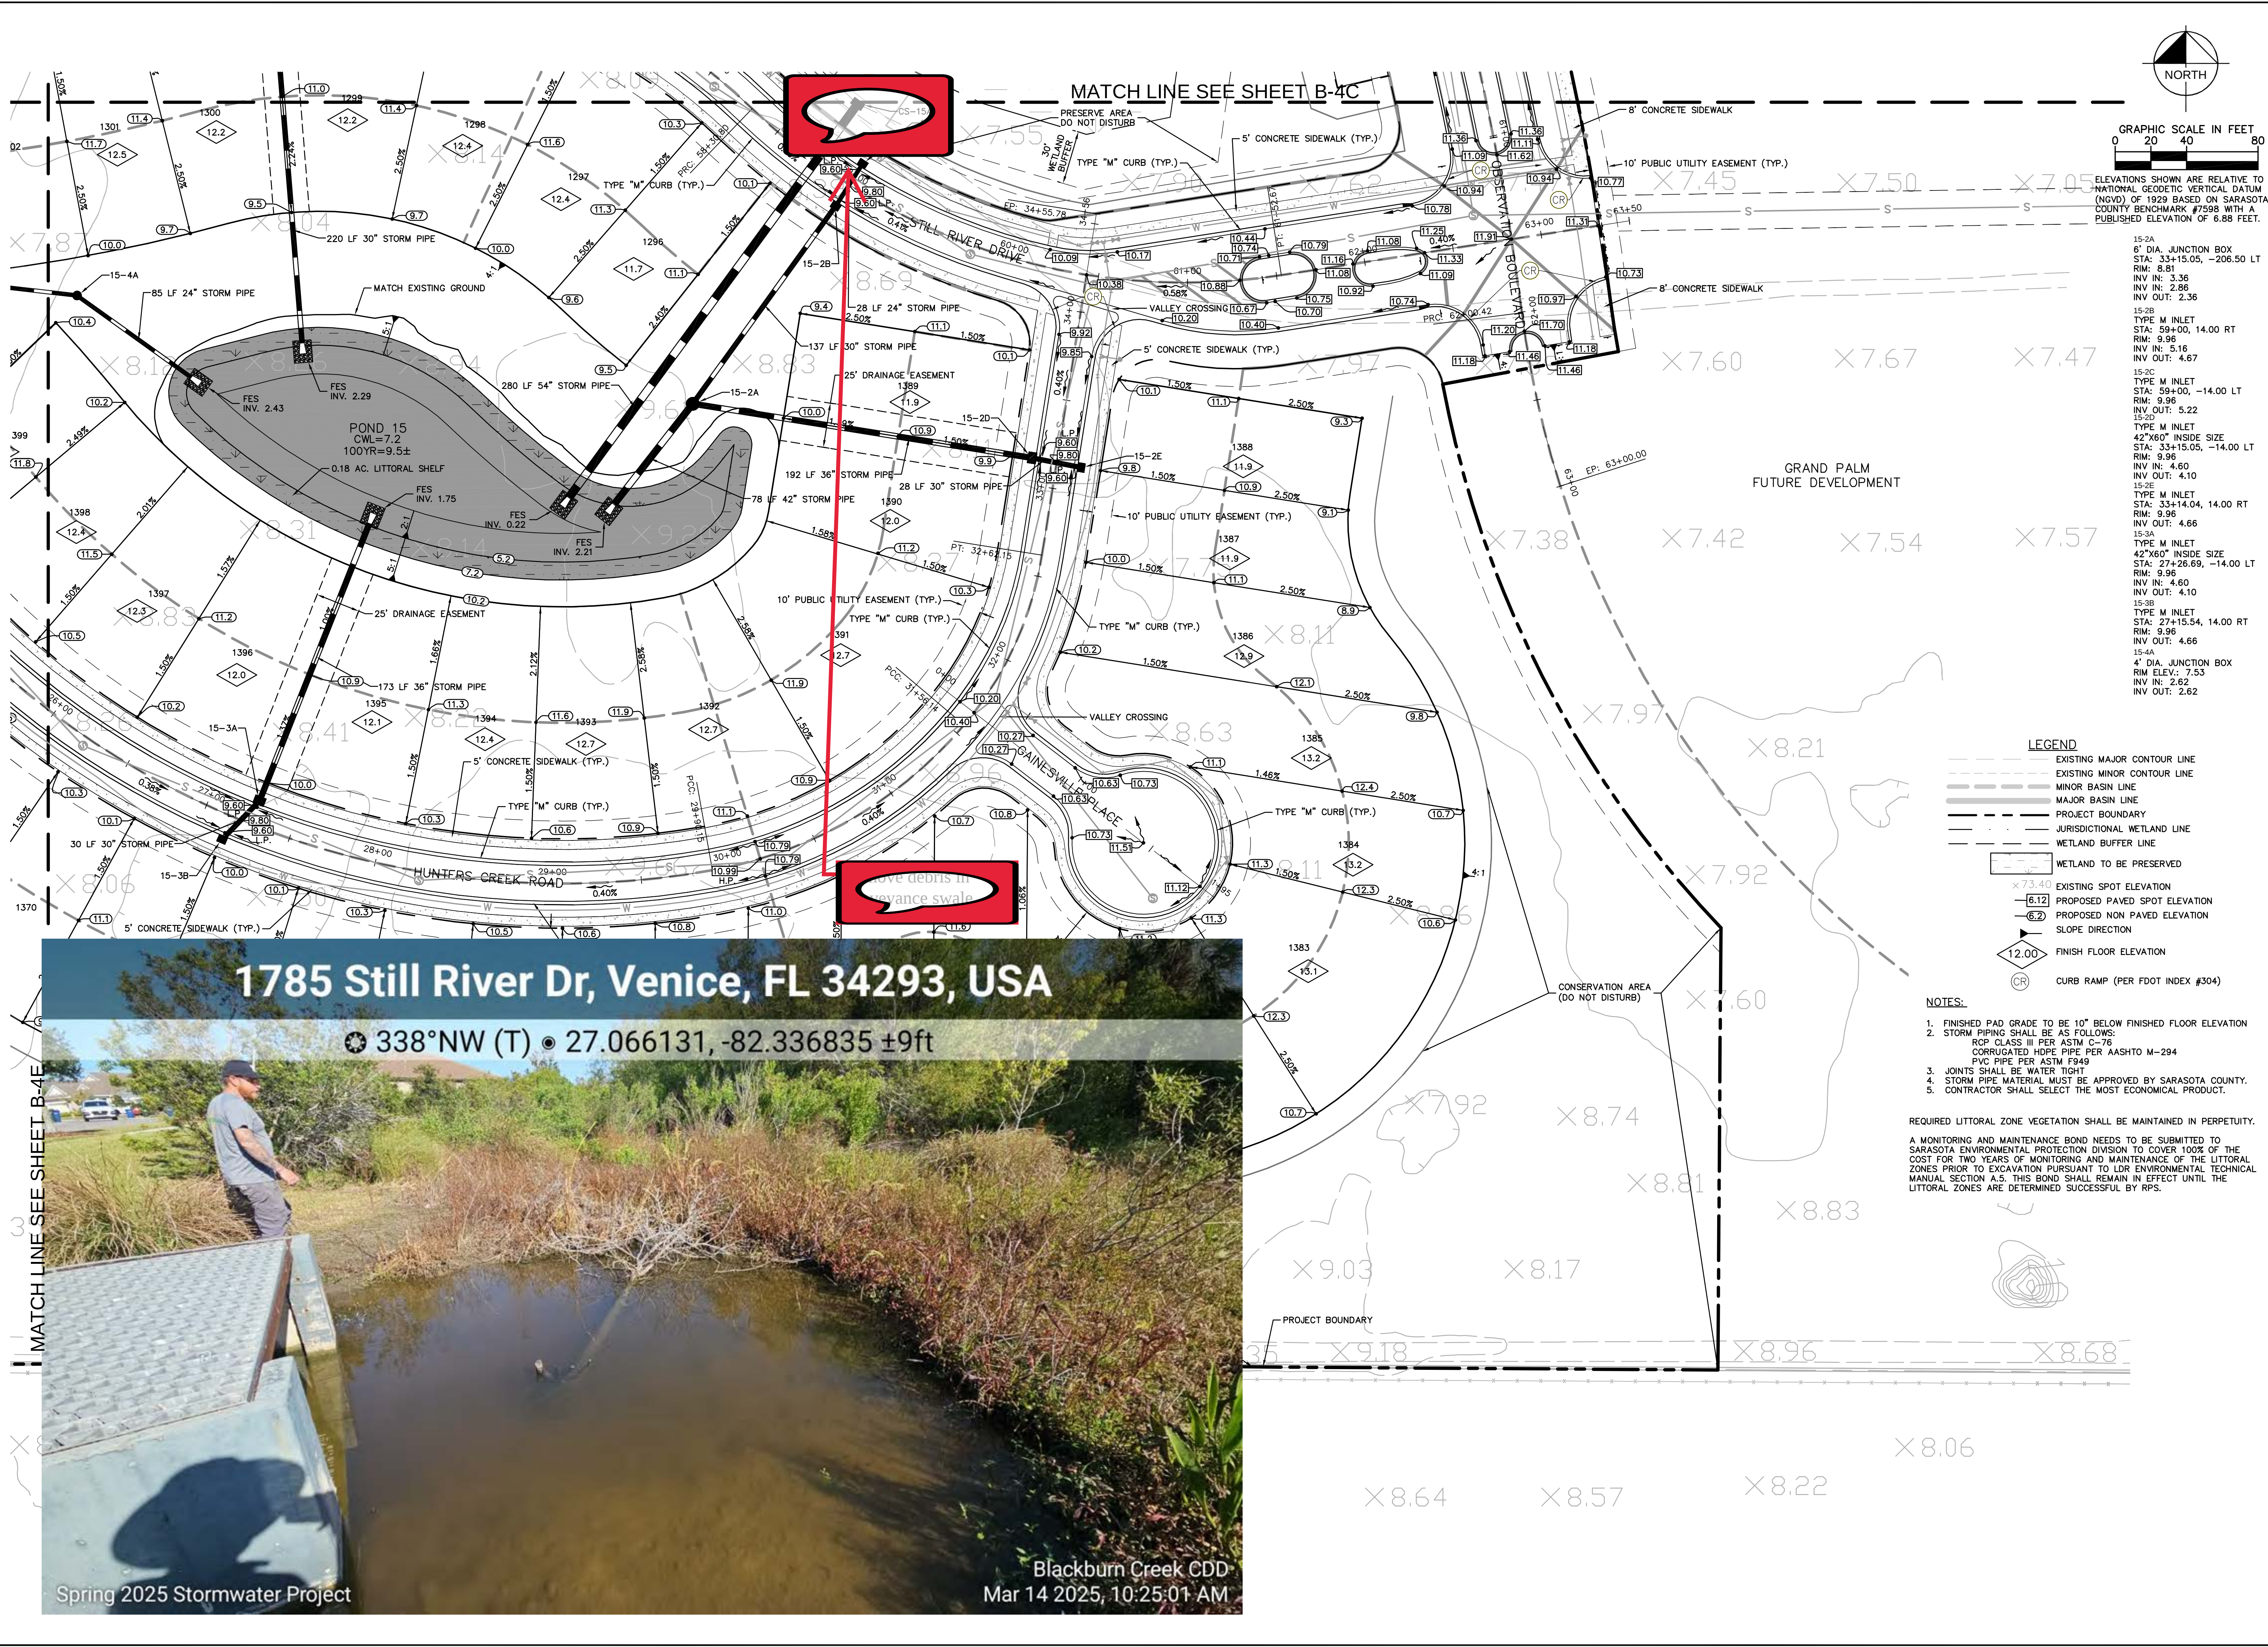

KIMLEY-HORN		THOMAS M. STOVALL		FLORIDA LICENSE NUMBER 41224	
KHA PROJECT 048119074		DATE APRIL 2015		SCALE AS SHOWN	
DESIGNED BY RBK		DRAWN BY RBK		CHECKED BY TMS	
DATE		DATE		DATE	
REVISIONS		No.		BY DATE	
GRAND PALM PHASE 3B		PREPARED FOR RESOURCE CONSERVATION OF SARASOTA, LLC		FLORIDA SARASOTA COUNTY	
SHEET NUMBER B-4F					

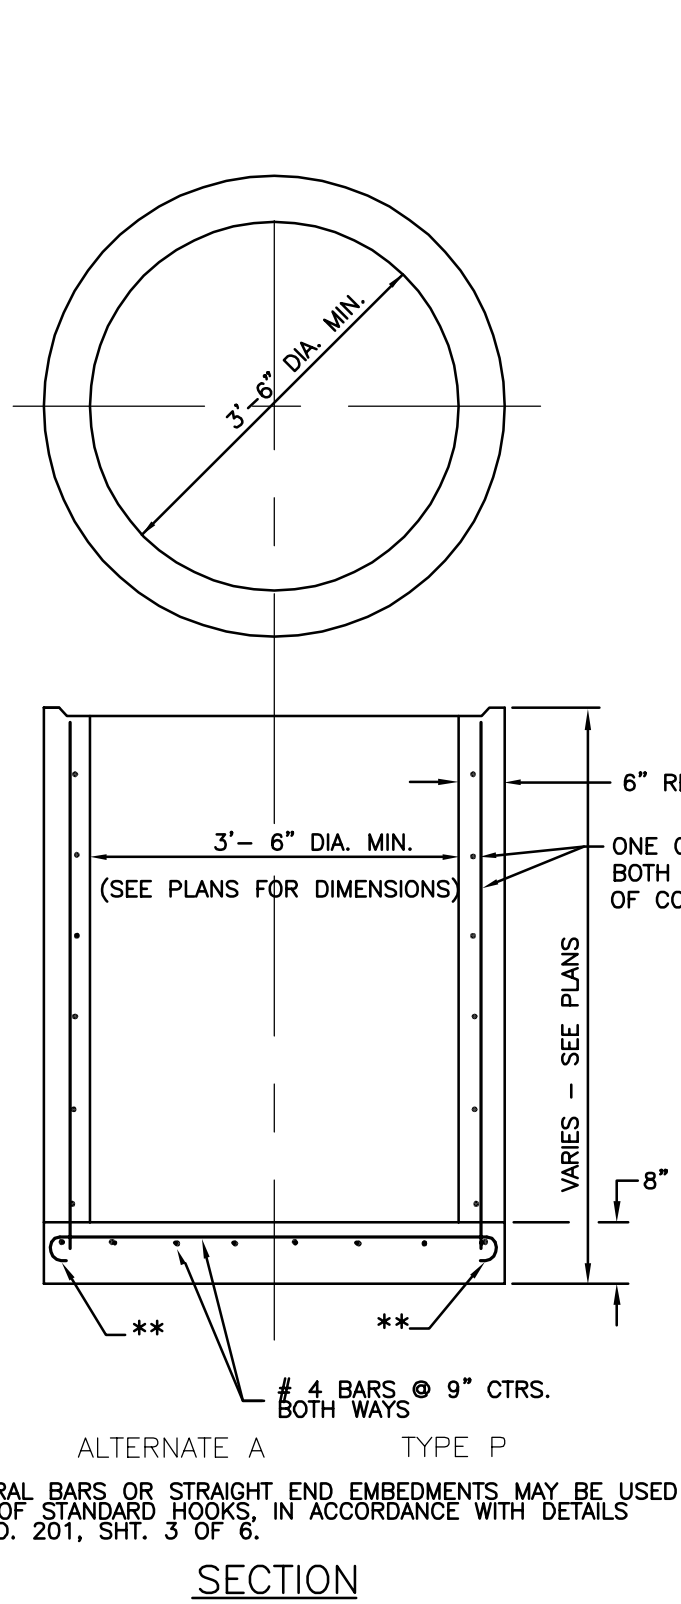

NOTE:

(1) ALL CONCRETE SHALL HAVE A COMPRESSIVE STRENGTH OF AT LEAST 4000 P.S.I. @ 28 DAYS.


(2) REINFORCING SHOWN IS THE MINIMUM REQUIRED. IF DIMENSIONS OF BOX REQUIRES ADDITIONAL REINFORCING, IN ORDER TO CARRY DESIGN LOADS, MANUFACTURER SHALL PROVIDE ADDITIONAL REINFORCING AS REQUIRED.

STANDARD JUNCTION BOX


NTS

LID SECTION

TYPE 8 (TRAFFIC) (H-20)

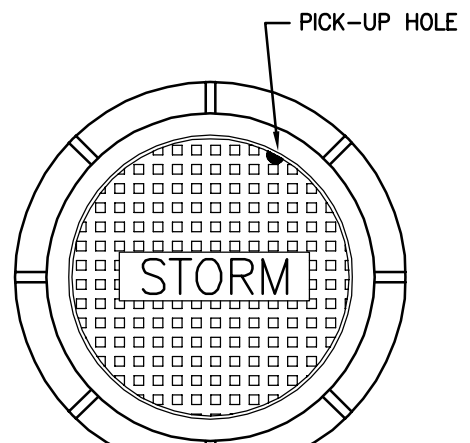


TOP VIEW

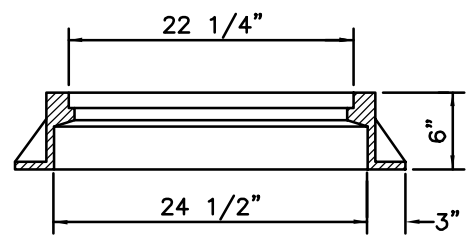


FRAME AND COVER SECTION

U.S. FOUNDRY 170 H OR APPROVED EQUAL
(WHEEL LOAD H-20)
1 FIELD COAT OF ASPHALTIC PAINT FOR FRAME AND COVER

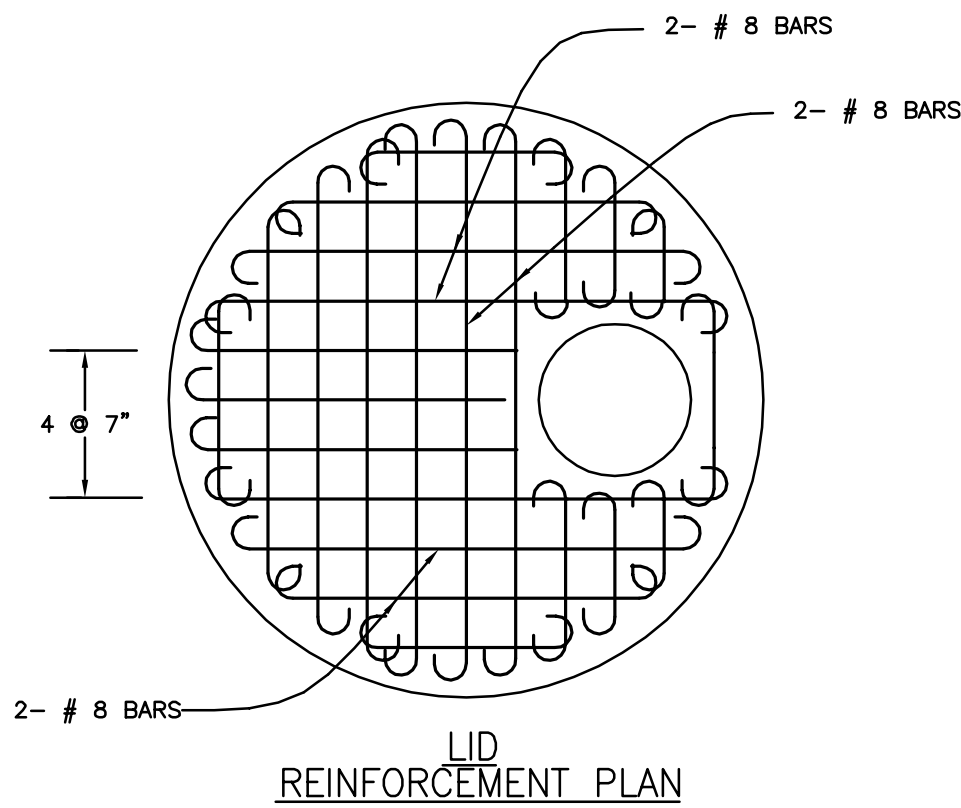


LID REINFORCEMENT PLAN

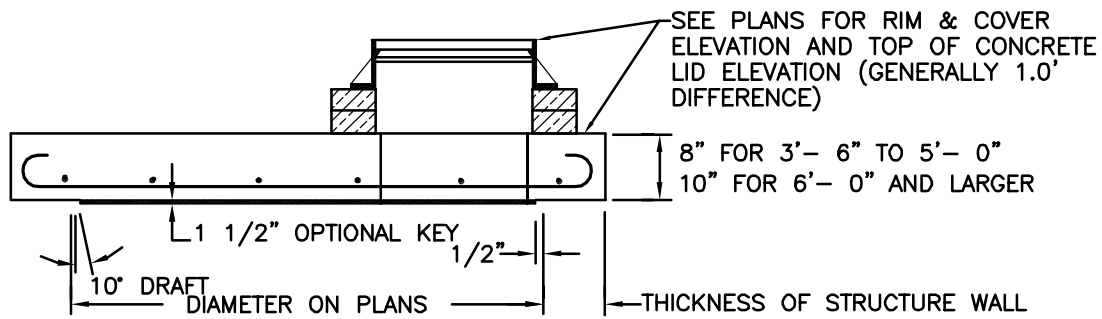


LID SECTION

TYPE 7-T (TRAFFIC) (H-20)

ALL REINFORCEMENT NO. 6 BARS EXCEPT 6-# 8 BARS SHOWN. BARS SPACED @ 6" CENTERS BOTH WAYS EXCEPT MIDDLE BARS @ 7" CENTERS. ALL BARS WITH ACI STANDARD HOOKS CANTED APPROX. 45°, OR EMBEDDED IN ACCORDANCE WITH THE SLAB REINFORCEMENT DETAIL SHOWN UNDER OPTIONAL CONSTRUCTION JOINTS. SHT.3 OF 6. EXCEPT ALL # 8 BARS AND # 6 BARS AROUND MANHOLE OPENING SHALL BE HOOKED.

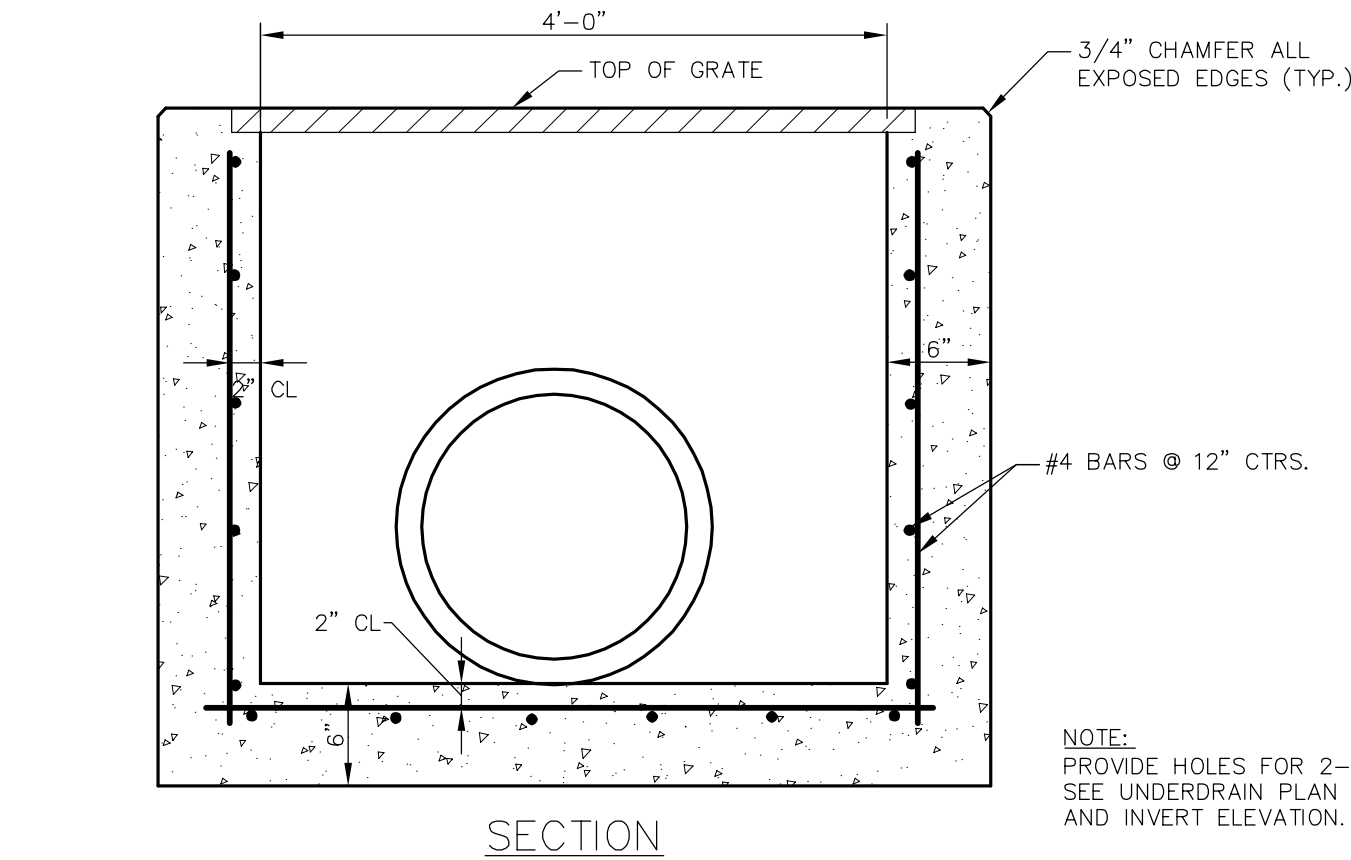

SECTION

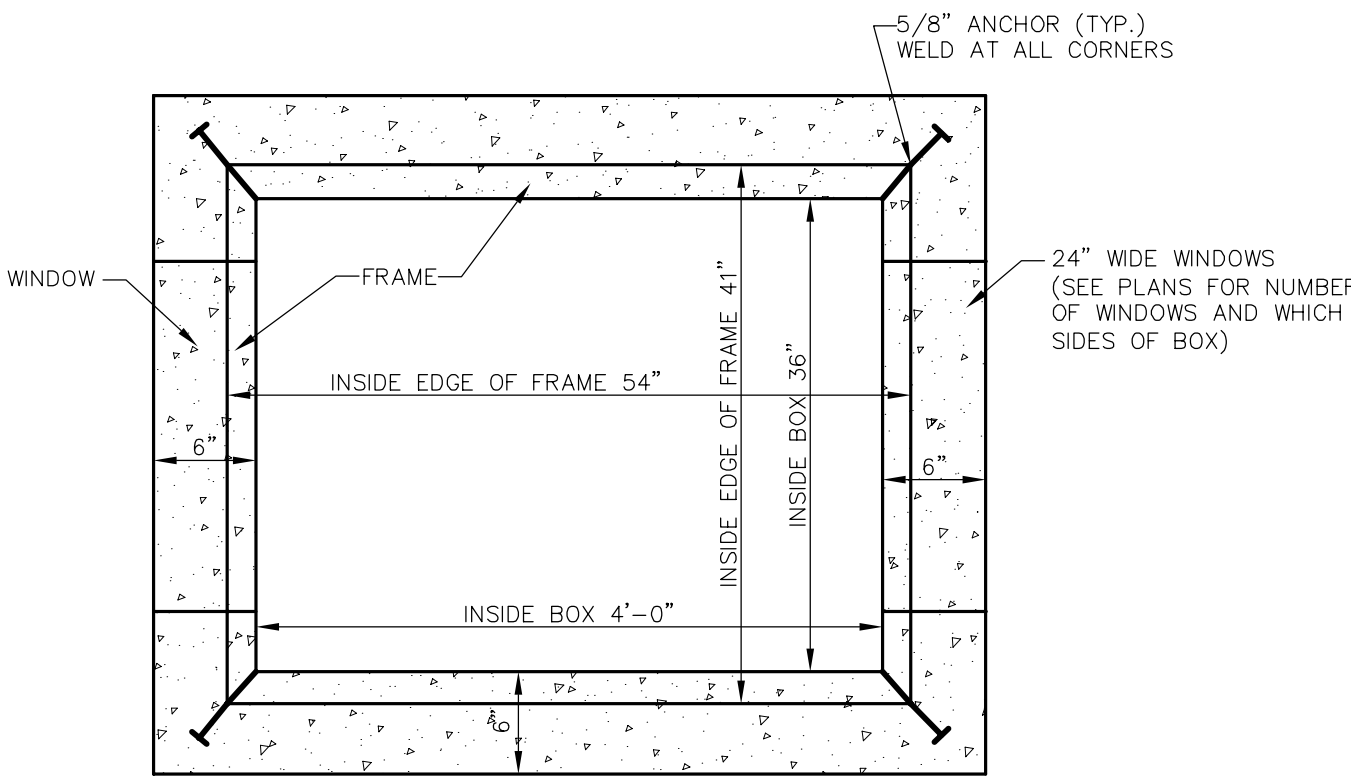

PLAN

NOTE:
SEE PAVING, DRAINAGE AND GRADING PLANS FOR PIPE SIZE, DIRECTION AND ELEVATIONS.

GRATED SWALE INLET DETAILS


NOTES:

1. TYPICAL ALL PIPES INTO LAKES

2. FLARED END SECTION TO BE IN ACCORDANCE WITH F.D.O.T. INDEX NO. 270.


3. TOE WALL REQUIRED EXCEPT WHEN FLARED END SECTION (F.E.S.) IS BEDDED ON UNDISTURBED ROCK SURFACE.

TABLE		
PIPE DIA.	D	E
15"	6'-1"	2'-0"
18"	6'-1"	2'-6"
24"	6'-1"	4'-0"
30"	6'-1 1/4"	5'-0"
36"	8'-1 1/4"	6'-0"
42"	8'-2"	6'-6"
48"	8'-2"	7'-0"
54"	8'-4"	7'-6"
60"	8'-3"	8'-0"

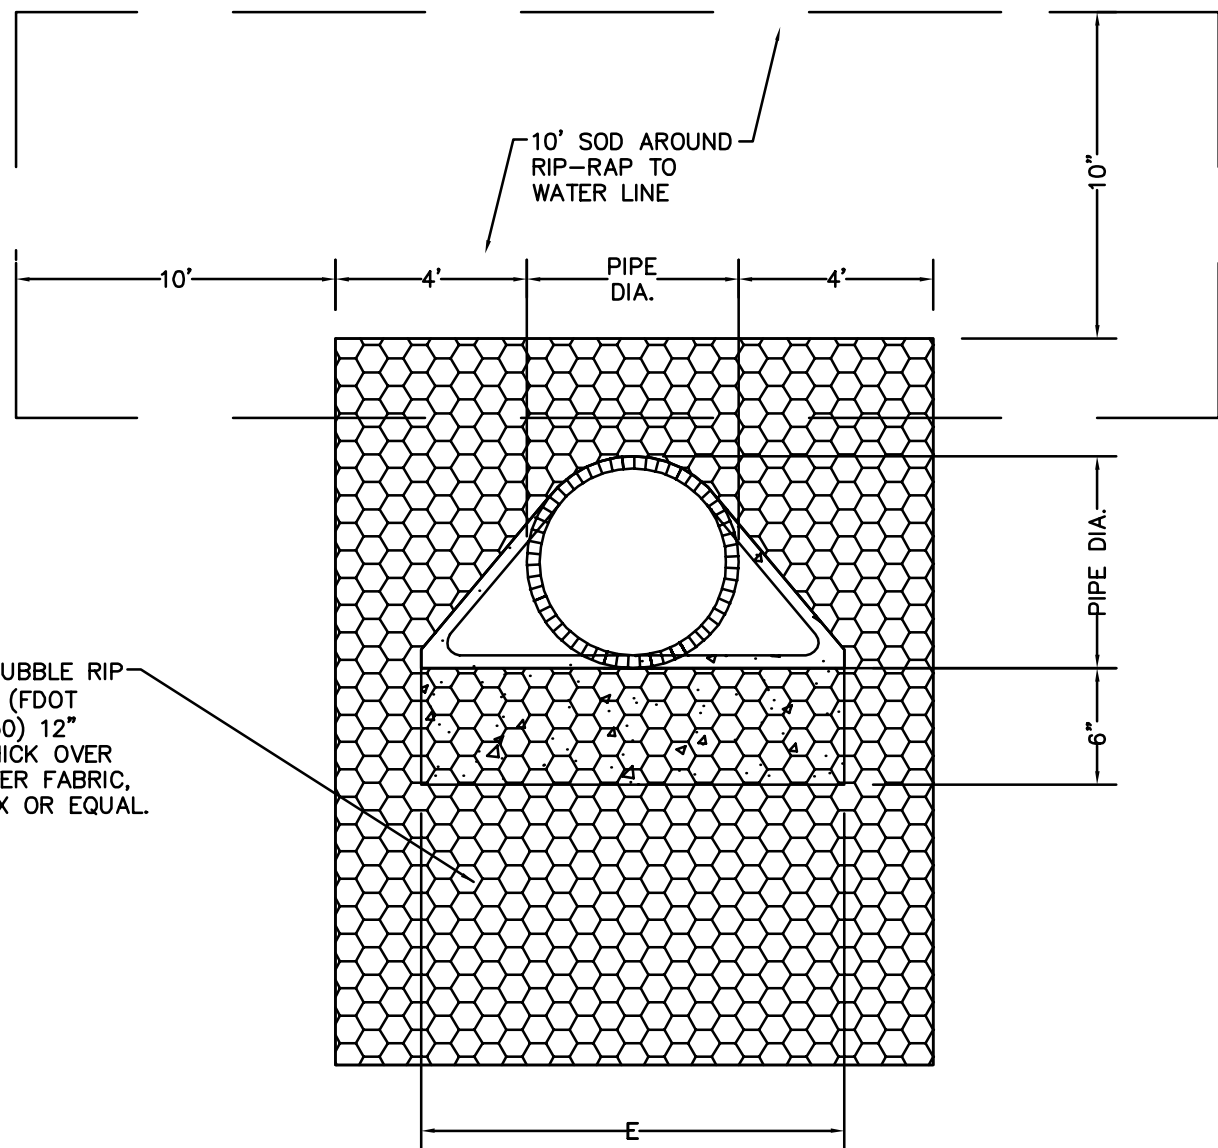


FLARED END SECTION PIPE

NTS

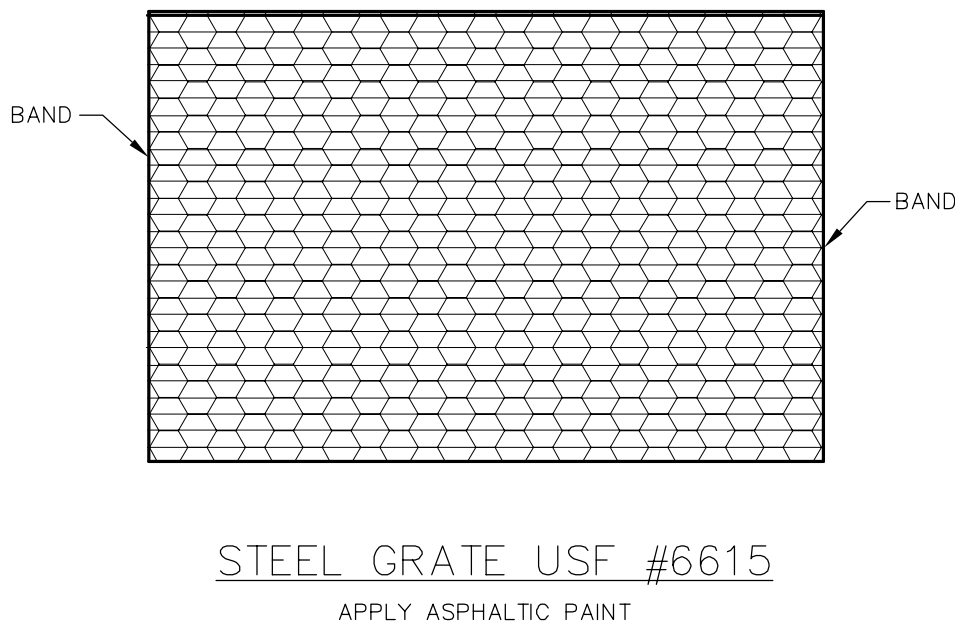

STEEL GRATE USF #6615

APPLY ASPHALTIC PAINT

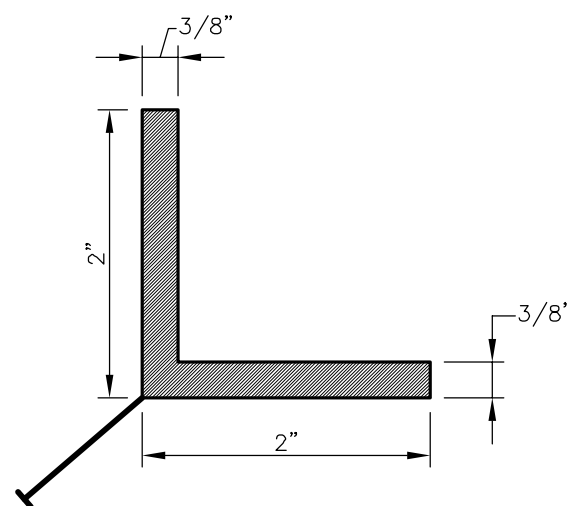

STEEL FRAME DETAIL

(ALL FOUR SIDES WELDED TOGETHER)

APPLY ASPHALTIC PAINT

NOTES:

1. ALL CONCRETE SHALL HAVE A COMPRESSIVE STRENGTH OF AT LEAST 4000 P.S.I. @ 28 DAYS.

2. ALL STEEL TO HAVE A MINIMUM 2" CLEARANCE UNLESS OTHERWISE NOTED.

3. STEEL REINFORCEMENT SHALL MEET ASTM SPECIFICATIONS (A-615), DEFORMED BARS.

4. ALL INLETS TO HAVE FIELD POURED INVERTS TO ELIMINATE STANDING WATER.

5. 3/4" CHAMFER ALL EXPOSED EDGES.

FLARED END,
GRATED SWALE
INLET & JUNCTION
BOX DETAILS

GRAND PALM PHASE 3B
PREPARED FOR
RESOURCE CONSERVATION OF
SARASOTA, LLC

SARASOTA COUNTY FLORIDA

SHEET NUMBER
B-9

LICENSED PROFESSIONAL
THOMAS M. STOVALL
FLORIDA LICENSE NUMBER
41224

KHA PROJECT
048119074
DATE
APRIL 2015
SCALE
AS SHOWN
DESIGNED BY
RBK
DRAWN BY
RBK
CHECKED BY
TMS

Kimley»Horn
© 2015 KIMLEY-HORN AND ASSOCIATES, INC.
1777 MAIN STREET, SUITE 200, SARASOTA, FL 34236
PHONE: 941-379-7600
WWW.KIMLEY-HORN.COM CA 00000696

No.

REVISIONS

DATE

BY

** ALL BUBBLER BOXES SHALL HAVE AN INSIDE BOTTOM ELEVATION 18" BELOW PIPE INVERT. THE CONTRACTOR IS REQUIRED TO PROTECT THESE SUMPS AND PIPES FROM DEBRIS AND SILTATION. ALL PIPES AND SUMPS SHALL BE FREE OF DEBRIS AND SILTATION AT FINAL PROJECT ACCEPTANCE. DO NOT POUR INVERTS IN BUBBLER BOXES.

Technical drawing of a rectangular box with a circular notch, showing dimensions and construction details. The drawing includes the following labels and dimensions:

- OUTSIDE BOX 84"
- ANGLE FRAME SEE DETAIL
- INSIDE BOX 72"
- WINDOW OPENING (VARIES)
- TOP OF GRATE
- 3/4" CHAMFER ALL EXPOSED EDGES (TYP.)
- TOP OF SKIMMER
- TOP OF SKIMMER
- 2 TYP.
- 1
- 2" CL.
- VARIES
- 4" MIN.
- 1 WINDOW
- 18"
- 1
- BOTTOM OF SKIMMER
- 6"
- 6"
- #4 BARS @ 8" CTRS.
- POURED INVERT TO PREVENT STANDING WATER
- 3" MIN. CL.
- #4 BARS @ 12" CENTERS
- WIDTH OF NOTCH

Technical drawing of a rectangular frame assembly. The drawing shows a cross-section of the frame with various dimensions and labels. The frame is composed of a central panel and a surrounding frame. The dimensions are as follows:

- INSIDE EDGE OF FRAME:** 79" (horizontal) and 41" (vertical).
- INSIDE BOX:** 72" (horizontal) and 36" (vertical).
- WELD AT ALL CORNERS (TYP.):** Indicated at the bottom left corner.
- WINDOW:** Labels pointing to the top, left, and right sides of the frame.
- 5/8" ANCHOR (TYP.):** Indicated at the top right corner.
- 6":** Dimension for the left side of the frame.
- 12":** Dimension for the bottom side of the frame.

POND 5
CWL=7.0
100YR=9.5±

CS-5

C.S.-OFF1

86 87 88 89 90 91 92 93 94 95 96 97 98 99

Diagram illustrating the components of a window elevation:

- ① WINDOW ELEV.
- ② WINDOW ELEV.
- ③ TOP CONTROL STRUCTURE
- 6" MIN.
- CONTROL STRUCTURE WALL

[illegible]

A diagram showing a hexagonal lattice structure. The lattice is composed of many interconnected hexagons, forming a grid-like pattern. Two labels, "BAND", are present: one on the left side with an arrow pointing to the left edge of the lattice, and one on the right side with an arrow pointing to the right edge of the lattice.

GALVANIZED STEEL GRATE USF #6620
(40" x 77-11/16" x 2")

- ① 1/4" THICK ALUMINUM FABRICATED SKIMMER PLATE WITH OPEN TOP AND BOTTOM.
- ② 3/8" DIAMETER STAINLESS STEEL EXPANSION ANCHORS, 3" LONG (MIN.) WITH STAINLESS STEEL WASHERS AND NUTS, THREE REQUIRED EACH SIDE OF SKIMMER.
- ③ 3/16" THICK NEOPRENE GASKET BETWEEN SKIMMER AND CONCRETE.
- ④ THE LARGE WINDOWS WILL REQUIRE A STIFFENER TOP AND BOTTOM ON THE LONG FRONT SIDE SKIMMER. THIS MAY BE AN ANGLE BAR OF LIKE MATERIAL USED FOR SKIMMER, WELDED TO SKIMMER PLATE FACE. DO NOT MIX MATERIALS.
- ⑤ SKIMMER LONGER THAN 4 FEET WILL REQUIRE BRACES, BOTH AT TOP AND BOTTOM OF SKIMMER TO CONTROL STRUCTURE. NO SPACING SHALL EXCEED 4 FEET WITHOUT A BRACE.

MEDIUM CONTROL STRUCTURE

The image contains two technical drawings related to wetland mitigation structures.

Top Drawing: Plan View of a Swale

- WETLAND:** The area to the left of the swale, labeled "HAND DIG ONLY IN WETLAND AREA".
- 30' BUFFER:** The distance from the wetland edge to the start of the swale.
- PLANT DISTURBED AREA IN BUFFER WITH NATIVE VEGETATION:** A rectangular area within the buffer zone.
- DO NOT DISTURB:** Labels pointing to the wetland area and the buffer zone.
- EXISTING GROUND:** Indicated by dashed lines.
- 2:1 IN WETLAND:** Slope ratio for the wetland side of the swale.
- 3:1 IN BUFFER ONLY:** Slope ratio for the buffer side of the swale.
- SWALE BOTTOM:** The bottom of the swale, shown as a series of parallel lines.
- VARIES:** Label for the width of the buffer zone.
- 5:1:** Slope ratio for the top of the berm.
- TOP OF BERM:** The top edge of the structure.
- SOD:** Sod (soil) area.
- LAKE CONTROL LINE (L.C.L.):** A vertical line to the right of the structure.

Bottom Drawing: Cross-Section of a Bubbler Structure

- WETLAND:** The area to the left of the structure.
- 30' BUFFER:** The distance from the wetland edge to the structure.
- EXISTING GROUND:** Indicated by a dashed line.
- TOP OF BERM:** The top edge of the structure.
- L.C.L.:** Lake Control Line.
- C.W.L.:** Centerline of the structure.
- VAR.:** Variable slope ratio for the berm.
- 5:** Slope ratio for the berm.
- 1:** Slope ratio for the berm.
- 3' ±:** Width of the structure.
- **BUBBLER STRUCTURE ONLY:** A note indicating the structure is a bubbler.

Text Description:

£ SWALE 0.5' BELOW £ WINDOW AND SHALL EXTEND TO ITS INTERSECTION WITH EXISTING GROUND (WIDTH OF SWALE BOTTOM TO BE THE WIDTH OF FRONT WINDOW (2' WIDE MIN.)). SWALE BOTTOM SHALL EXTEND TO SIDE AND REAR WINDOWS, IF ANY.

SAND/CEMENT BAGS LAID END TO END AND SIDE TO SIDE UNIFORMLY 3' WIDE ON FRONT AND BOTH SIDE OF STRUCTURE WITH TOP OF BAGS TO BE 0.5' BELOW £ WINDOW OR FLUSH WITH EXIST. GROUND WHICH EVER IS LOWEST. BAGS SHALL BE LAID ON FILTER FABRIC ON A LEVEL FLAT PLANE (THERE SHALL NOT BE ANY VOIDS BETWEEN BAGS OR EXIST. GROUND).

CONTROL STRUCTURE WHEN LOCATED AT WETLAND

NOTE:
CONSTRUCTION IN WETLANDS SHOULD BE ACCESSED FROM THE UPLAND SIDE.
ANY TEMPORARY IMPACT AREAS IN THE WETLAND SHOULD BE REGRADED AND
RESTORED TO THEIR NATURAL CONDITION. CONSTRUCTION LIMITS IN WETLAND
SHOULD NOT EXTEND MORE THAN 10 FEET FROM THE EDGE OF THE
STRUCTURE UNLESS WETLAND SWALE IS REQUIRED.

SHEET NUMBER		B-10	
GRAND PALM PHASE 3B PREPARED FOR RESOURCE CONSERVATION OF SARASOTA, LLC		FLORIDA SARASOTA COUNTY	
MEDIUM CONTROL STRUCTURE DETAILS		KHA PROJECT 048119074 DATE APRIL 2015 SCALE AS SHOWN DESIGNED BY KHA DRAWN BY RBK CHECKED BY TMS DATE: _____	
LICENSED PROFESSIONAL		THOMAS M. STOVALL FLORIDA LICENSE NUMBER 41224	
Kimley»»Horn		© 2015 KIMLEY-HORN AND ASSOCIATES, INC. 1777 MAIN STREET, SUITE 200, SARASOTA, FL 34236 PHONE: 941-379-7600 WWW.KIMLEY-HORN.COM CA 0000696	
		No.	REVISIONS
		DATE	BY





CONTROL STRUCTURE NO.	TOP OF STRUCTURE / GRATE ELEV.	FLOWLINE WINDOW ELEV.	RECTANGULAR WEIR SIZE (SLOT) (WINDOWS)				NOTCH ELEV.	NOTCH WIDTH	PIPE SIZE / TYPE	OUTFALL PIPE INVERT	SKIMMER? YES/NO	SPECIAL COMMENT
			FRONT	REAR	SIDES	TOTAL						
CS-13A	9.5	7.5	5'	--	--	5'	--	--	60"	-0.61	NO	BUBBLER
(RECORD DATA)												
CS-14	9.6	7.0	5'	--	--	5'	--	--	60"	1.50	NO	BUBBLER
(RECORD DATA)												
--	--	--	--	--	--	--	--	--	--	--	--	--
(RECORD DATA)												
--	--	--	--	--	--	--	--	--	--	--	--	--
(RECORD DATA)												


CONSTRUCTION IN WETLANDS SHOULD BE ACCESSED FROM THE UPLAND SIDE. ANY TEMPORARY IMPACT AREAS IN THE WETLAND SHOULD BE REGRADED AND RESTORED TO THEIR NATURAL CONDITION. CONSTRUCTION LIMITS IN WETLAND SHOULD NOT EXTEND MORE THAN 10 FEET FROM THE EDGE OF THE STRUCTURE UNLESS WETLAND SWALE IS REQUIRED.

** 6" ROCK RIP-RAP ON FILTER FABRIC EMBEDDED AND LAID UNIFORMLY FLUSH WITH GROUND 5' WIDE AROUND ALL 4 SIDES OF THE STRUCTURE. TOP OF ROCK RIP-RAP TO BE A MINIMUM OF 6" BELOW WINDOW FLOW LINES OR FLUSH WITH GROUND WHICHEVER IS LOWEST.

** ALL BUBBLER BOXES SHALL HAVE AN INSIDE BOTTOM ELEVATION 18" BELOW PIPE INVERT. THE CONTRACTOR IS REQUIRED TO PROTECT THESE SUMPS AND PIPES FROM DEBRIS AND SILTATION. ALL PIPES AND SUMPS SHALL BE FREE OF DEBRIS AND SILTATION AT FINAL PROJECT ACCEPTANCE. DO NOT POUR INVERTS IN BUBBLER BOXES.

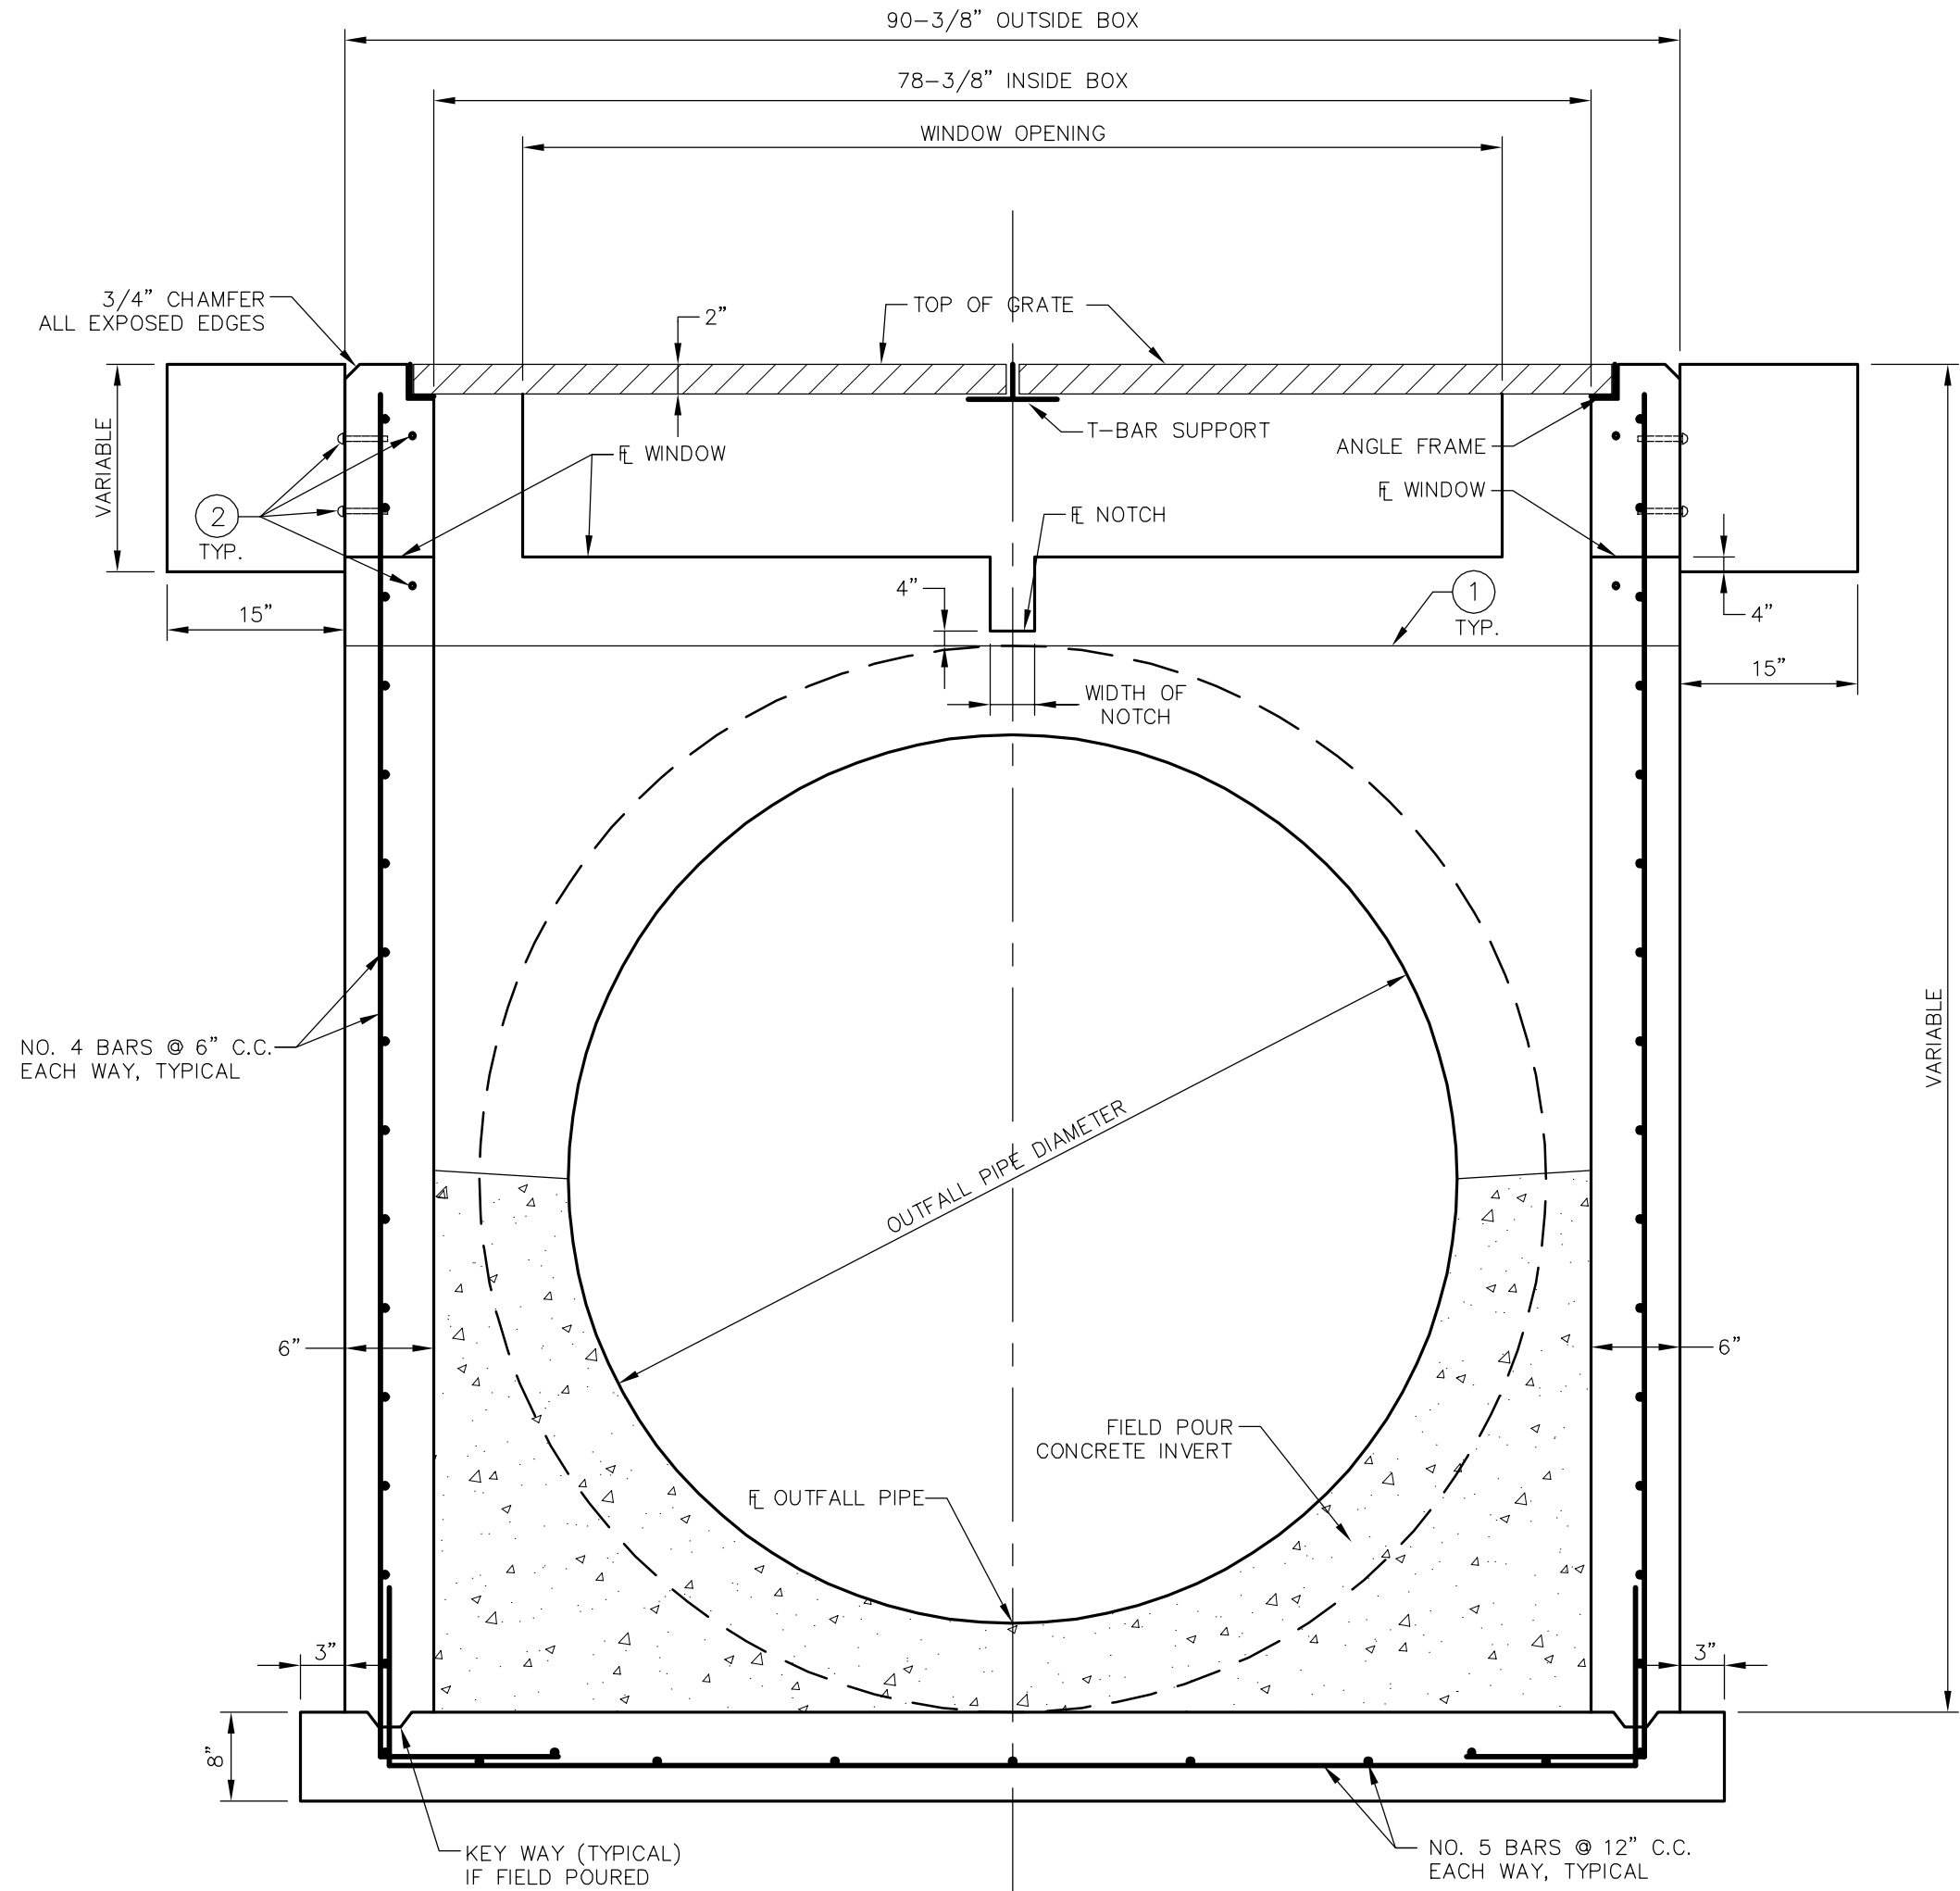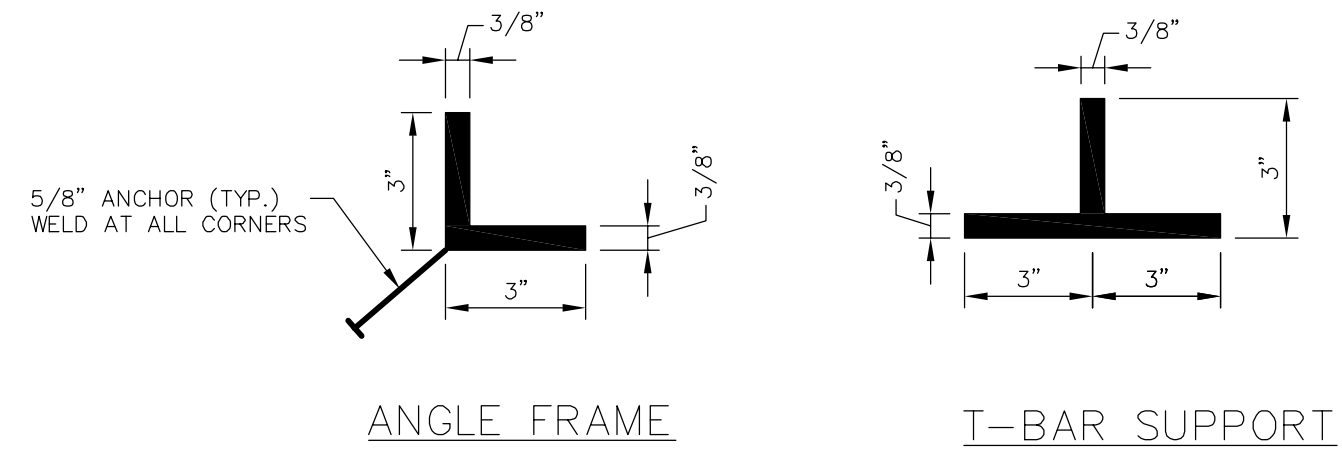

SECTION "A-A"

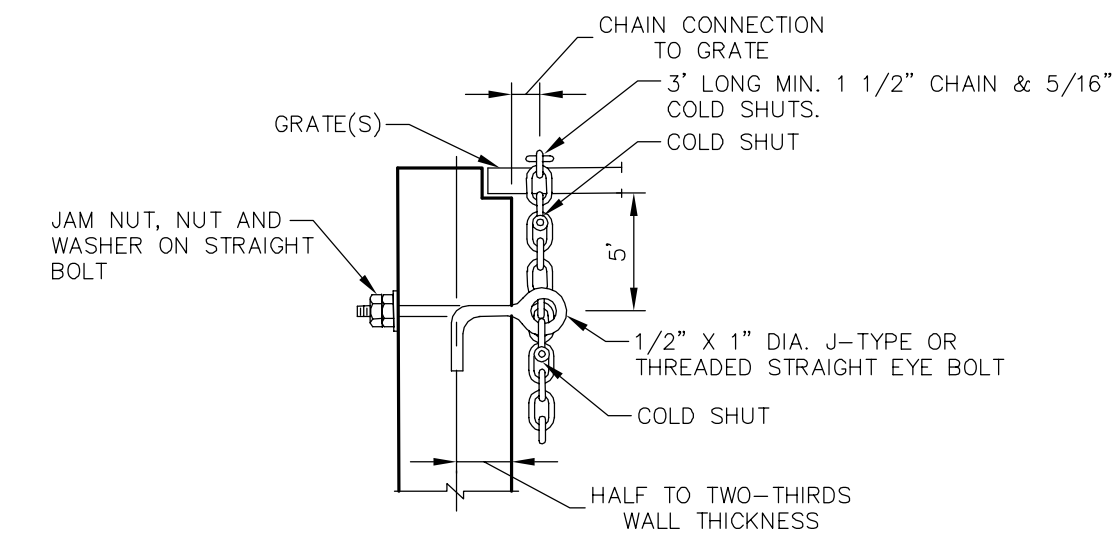

COST OF EYE BOLT AND CHAIN TO BE INCLUDED IN THE CONTRACT UNIT PRICE FOR STRUCTURES.
ONE EYE BOLT & CHAIN FOR EACH GRATE.



EYE BOLT AND CHAIN FOR LOCKING GRATES TO STRUCTURES N.T.S.

- NOTES:
- ALL CONCRETE SHALL HAVE A COMPRESSIVE STRENGTH OF AT LEAST 4000 P.S.I. @ 28 DAYS.
 - ALL STEEL TO HAVE A MINIMUM 2-1/2" CLEARANCE UNLESS OTHERWISE NOTED.
 - STEEL REINFORCEMENT SHALL MEET ASTM SPECIFICATIONS (A-615), DEFORMED BARS
 - ALL INLETS TO HAVE FIELD POURED INVERTS TO ELIMINATE STANDING WATER.
 - 3/4" CHAMFER ALL EXPOSED EDGES.
 - ALL EXPOSED STEEL AND IRON SHALL HAVE ONE SHOP COAT RUST INHIBITOR AND ONE FIELD COAT OF KOPPERS 300 BITUMASTIC EPOXY BASED PAINT, 8 MILS D.F.T.


- 1/4" THICK ALUMINUM FABRICATED SKIMMER PLATE WITH OPEN TOP AND BOTTOM.
- 3/8" DIAMETER STAINLESS STEEL EXPANSION ANCHORS, 3" LONG (MIN.) WITH STAINLESS STEEL WASHERS AND NUTS. THREE REQUIRED EACH SIDE OF SKIMMER.
- 3/16" THICK NEOPRENE GASKET BETWEEN SKIMMER AND CONCRETE.
- THE LARGE WINDOWS WILL REQUIRE A STIFFENER TOP AND BOTTOM ON THE LONG FRONT SIDE SKIMMER. THIS MAY BE AN ANGLE BAR OF LIKE MATERIAL USED FOR SKIMMER, WELDED TO SKIMMER PLATE FACE. DO NOT MIX MATERIALS.
- SKIMMER LONGER THAN 4 FEET WILL REQUIRE BRACES, BOTH AT TOP AND BOTTOM OF SKIMMER TO THE CONTROL STRUCTURE. NO SPACING SHALL EXCEED 4 FEET WITHOUT A BRACE.

SEE PAVING, DRAINAGE AND GRADING PLANS FOR PIPE SIZES, LOCATIONS AND INVERT ELEVATIONS


DOUBLE GRATE CONTROL STRUCTURE N.T.S.

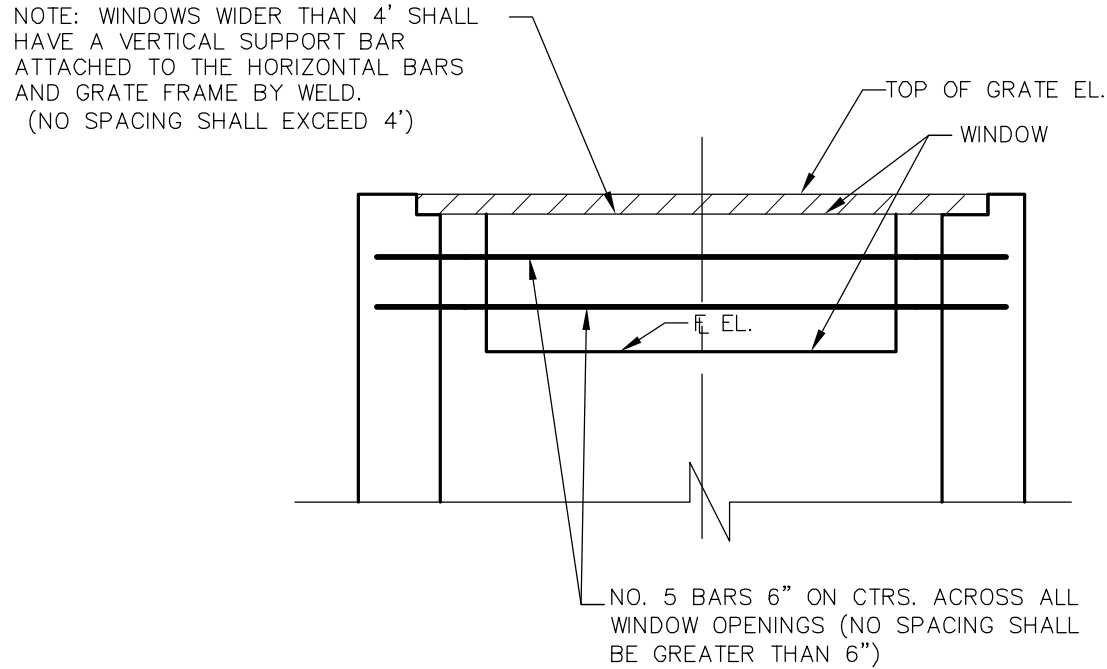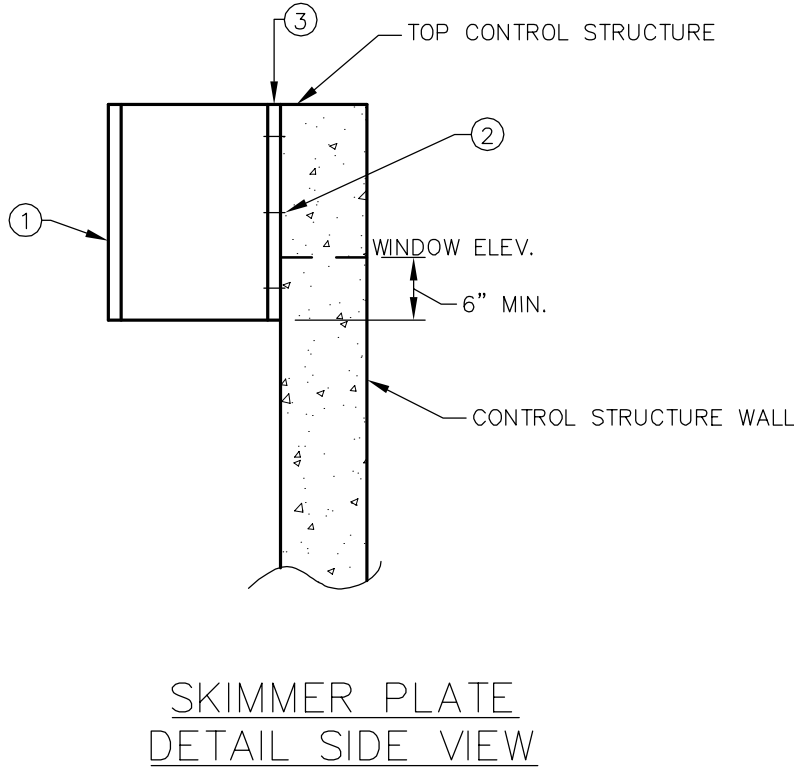


SECTION

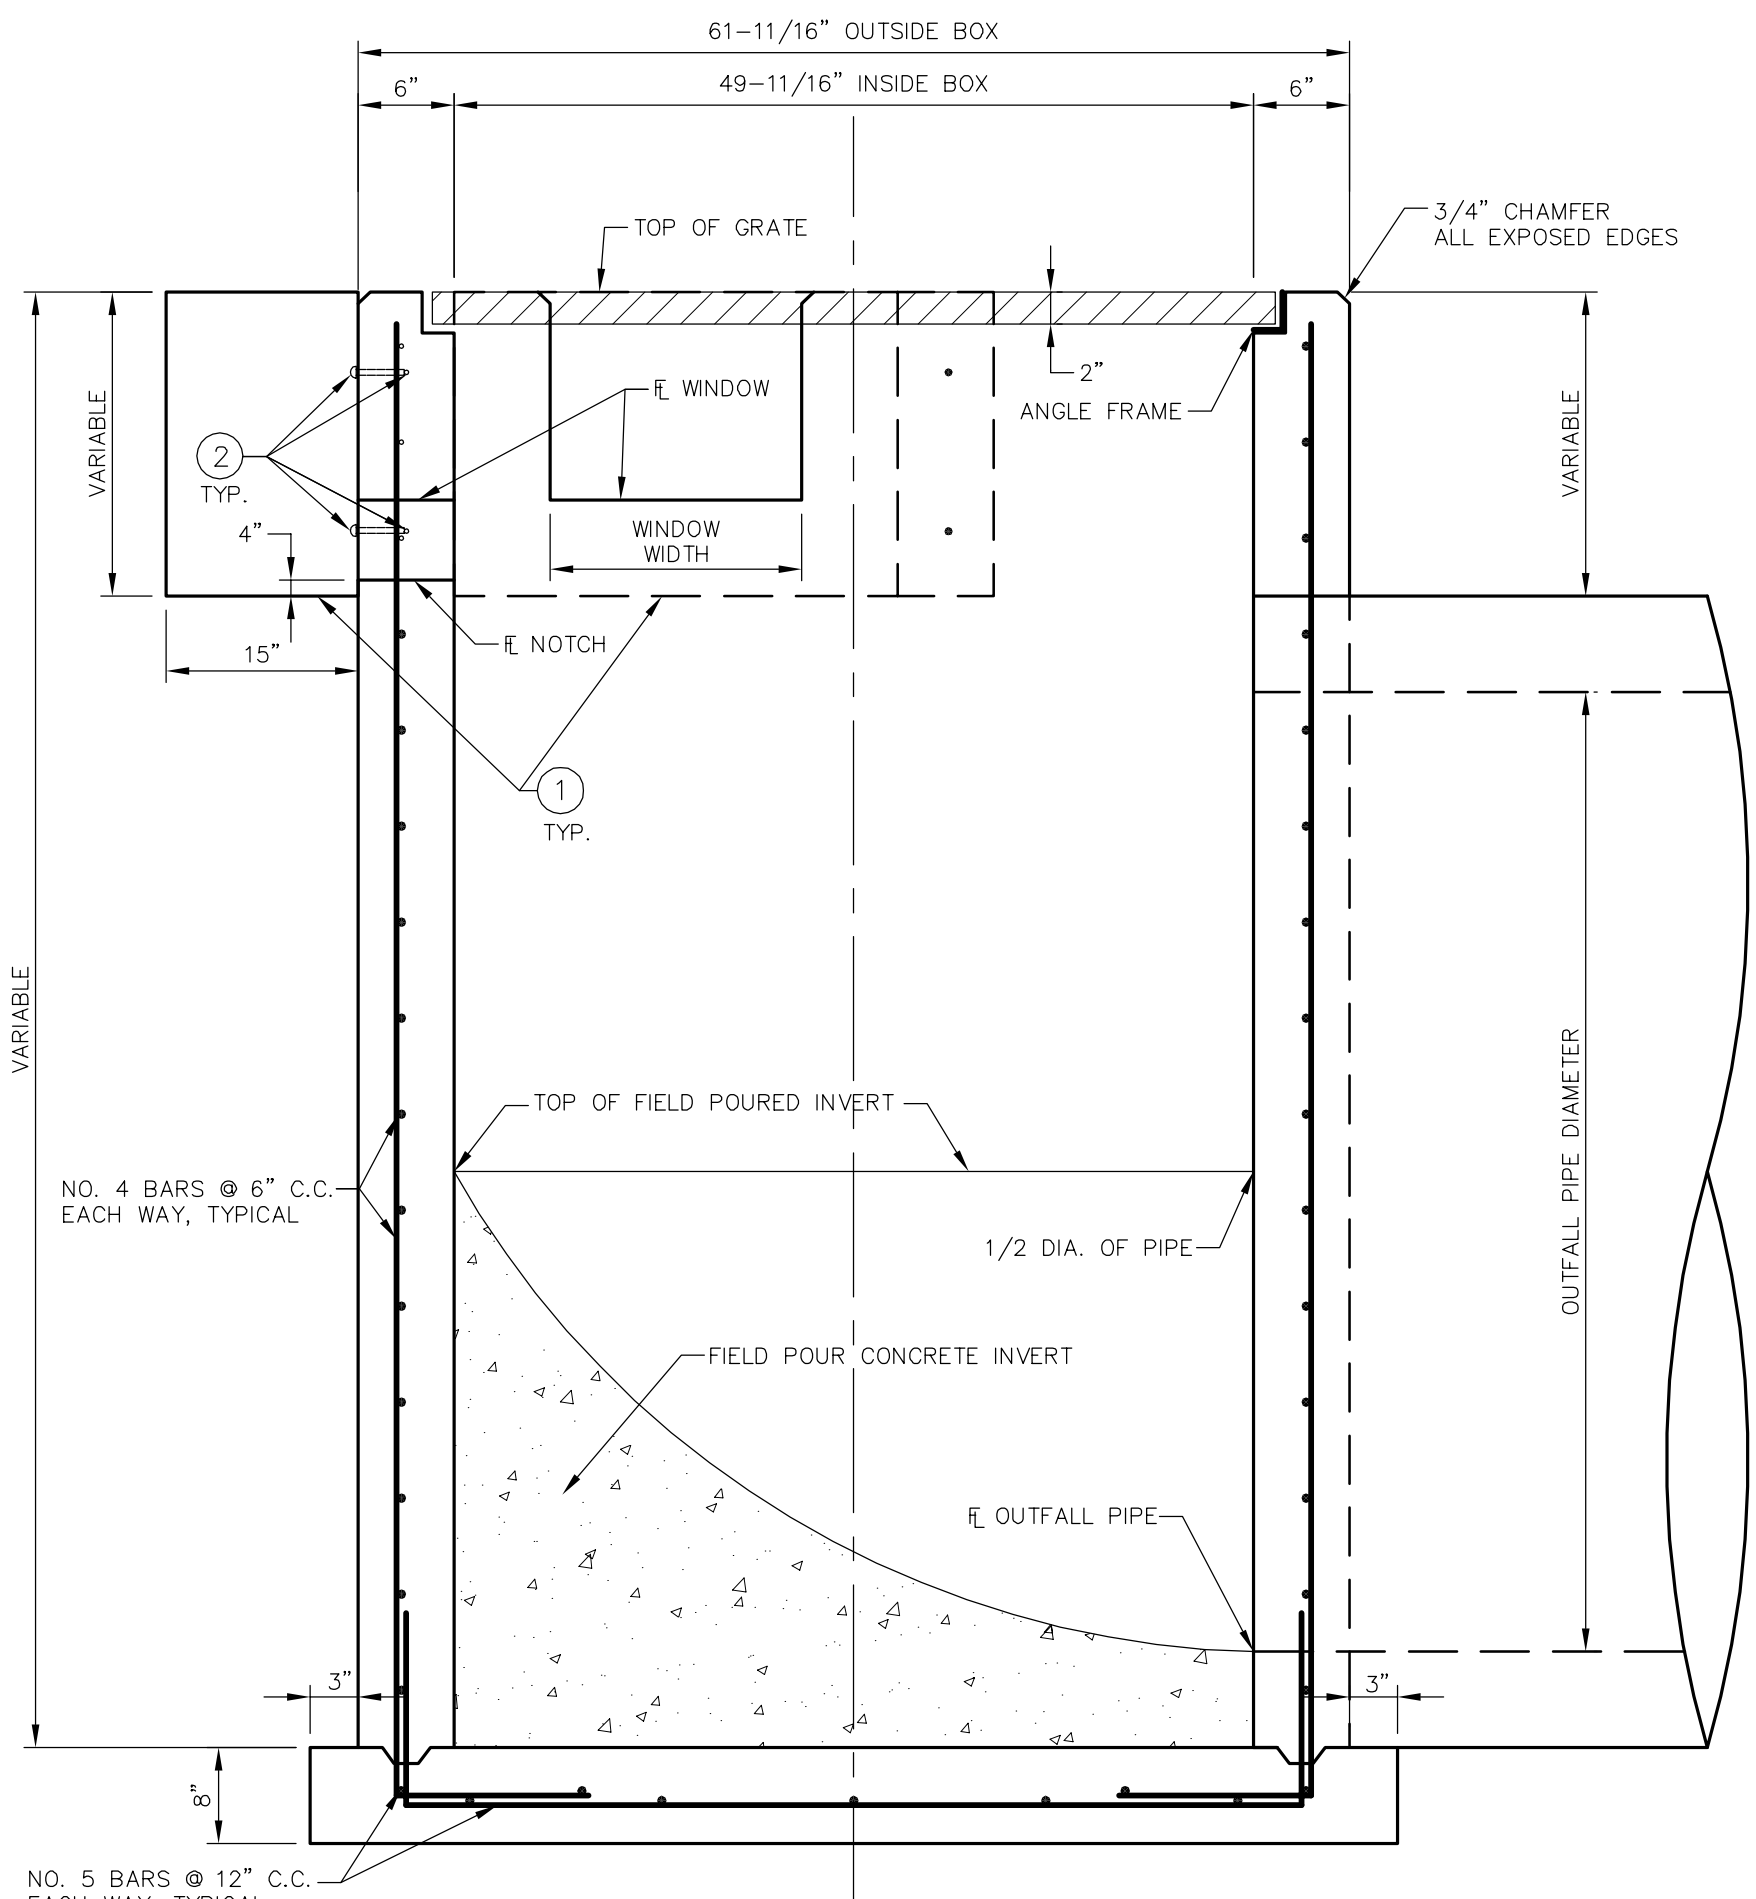


SECTION "B-B"

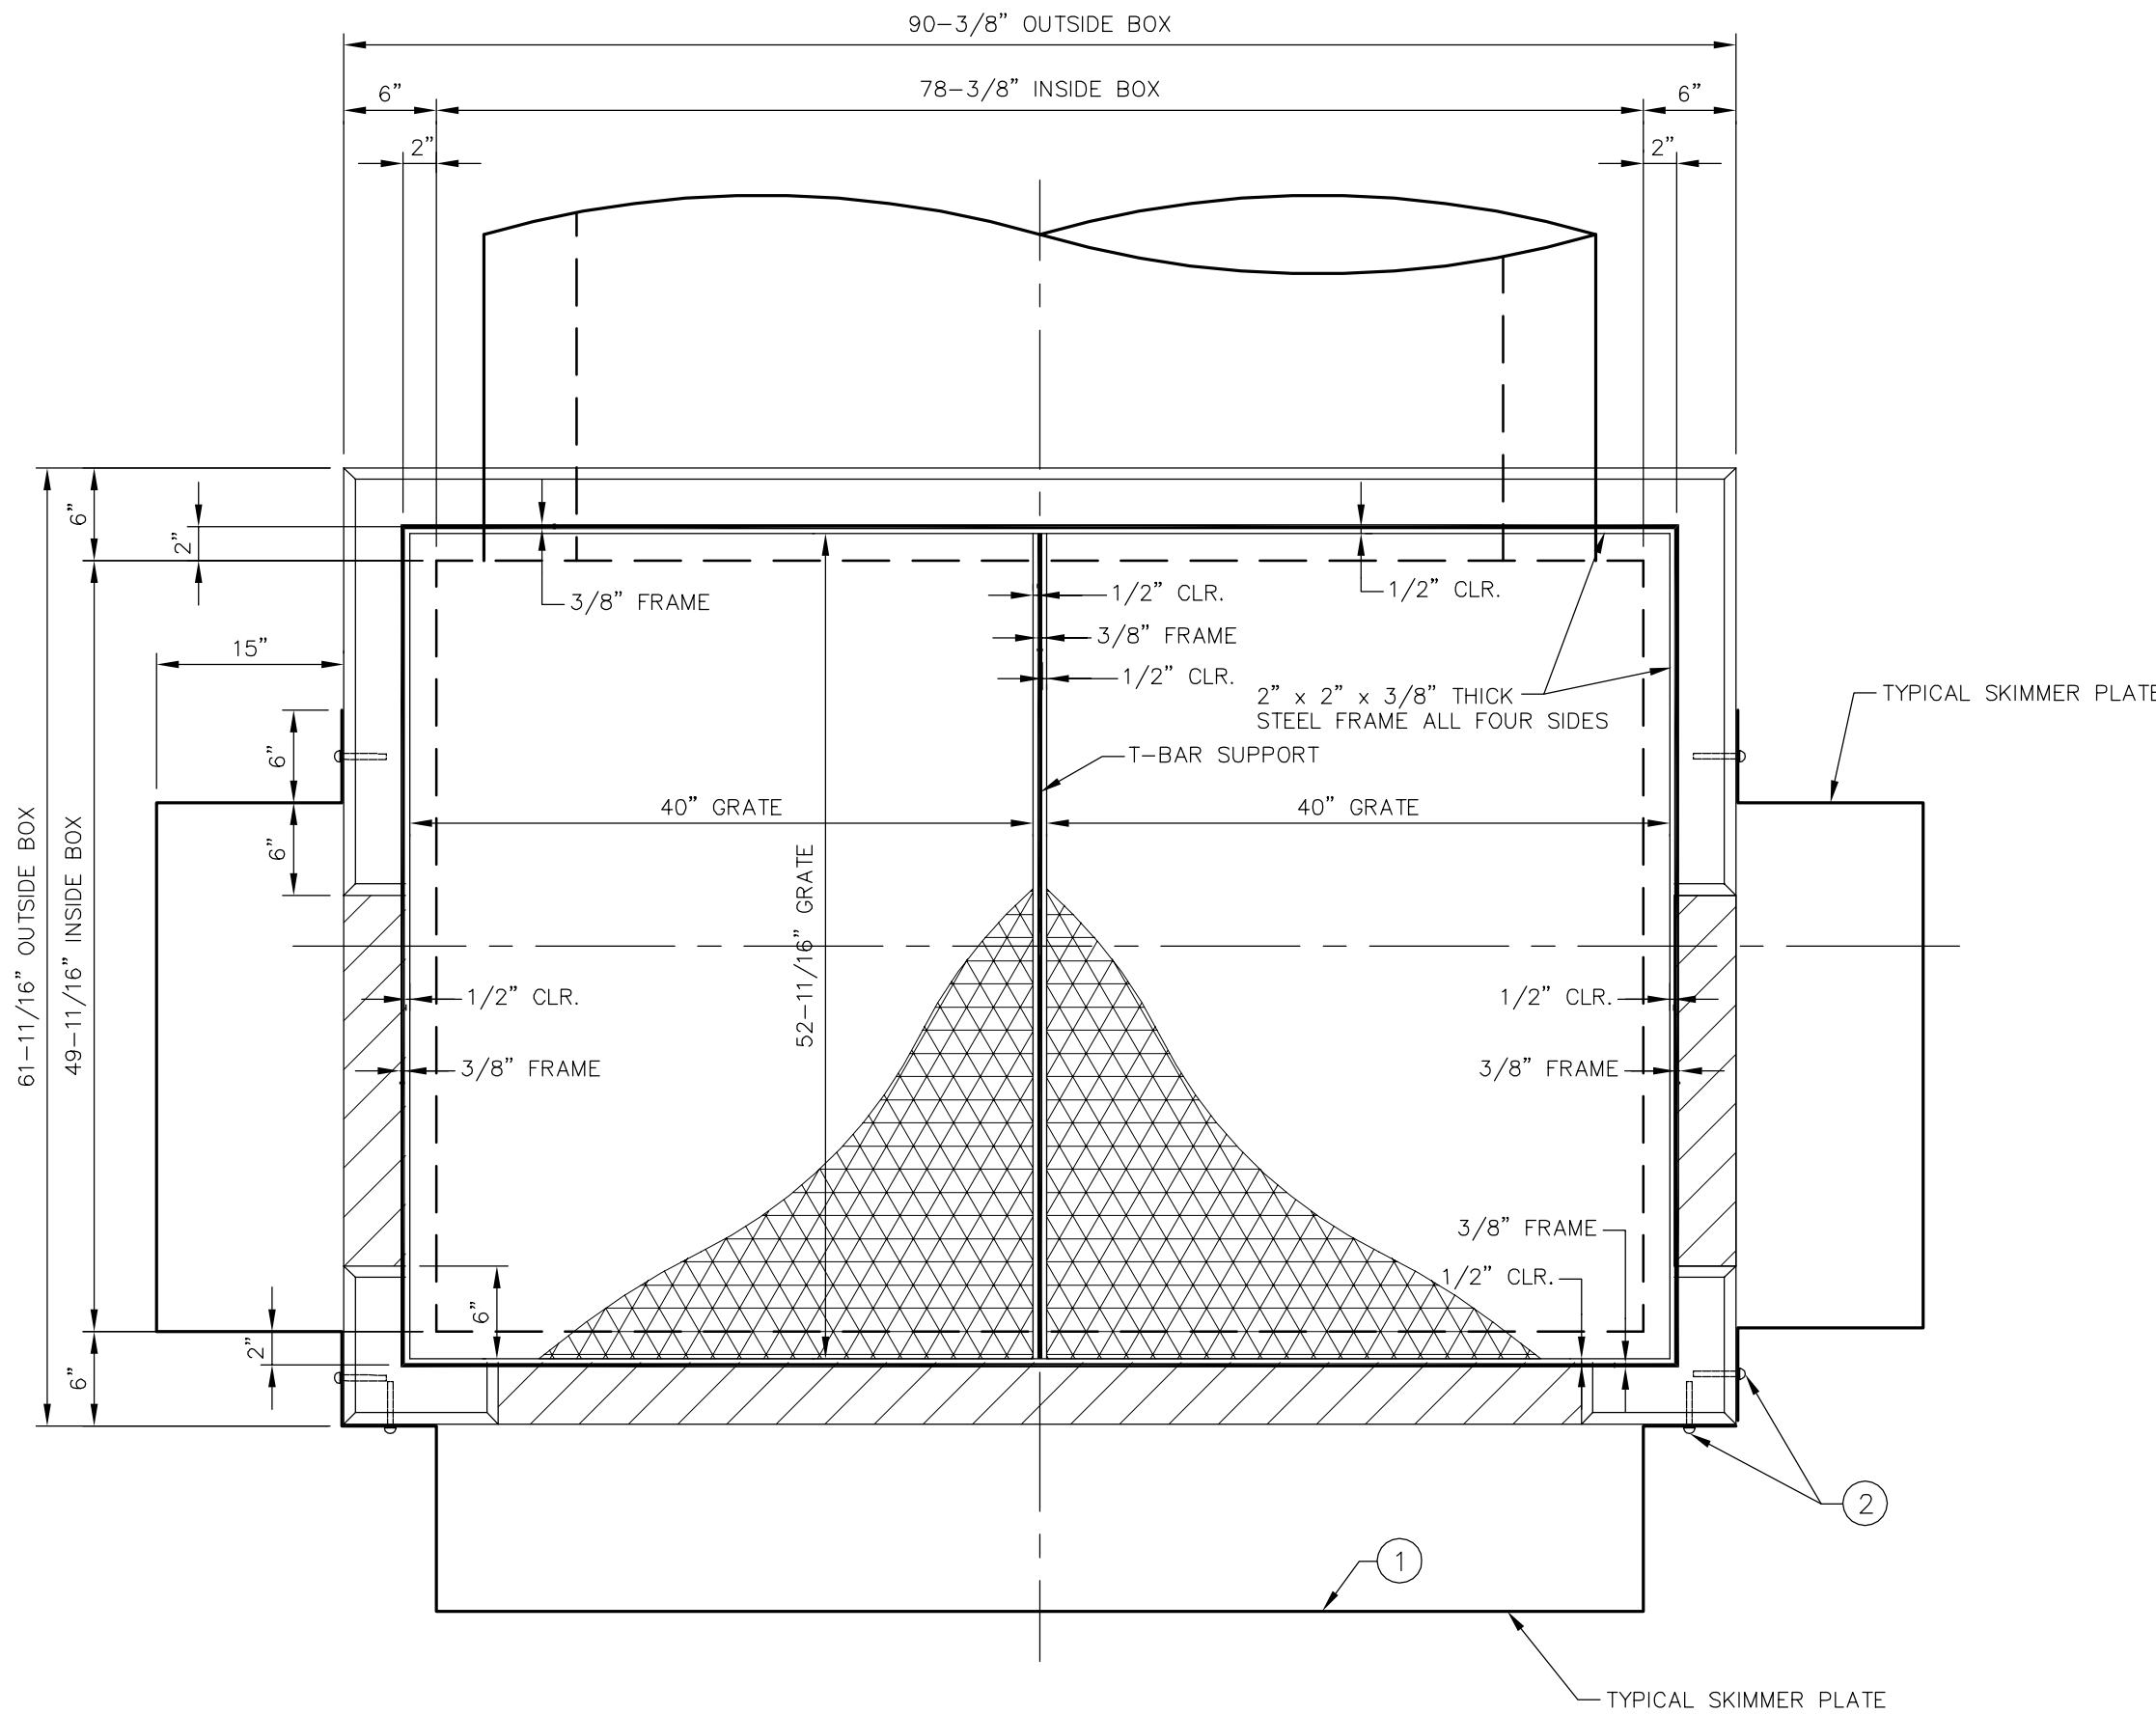

PLAN VIEW
2 - U.S. FOUNDRY NO. 6615 GALVANIZED STEEL
GRATES REQUIRED (52-11/16" x 40" x 2"):

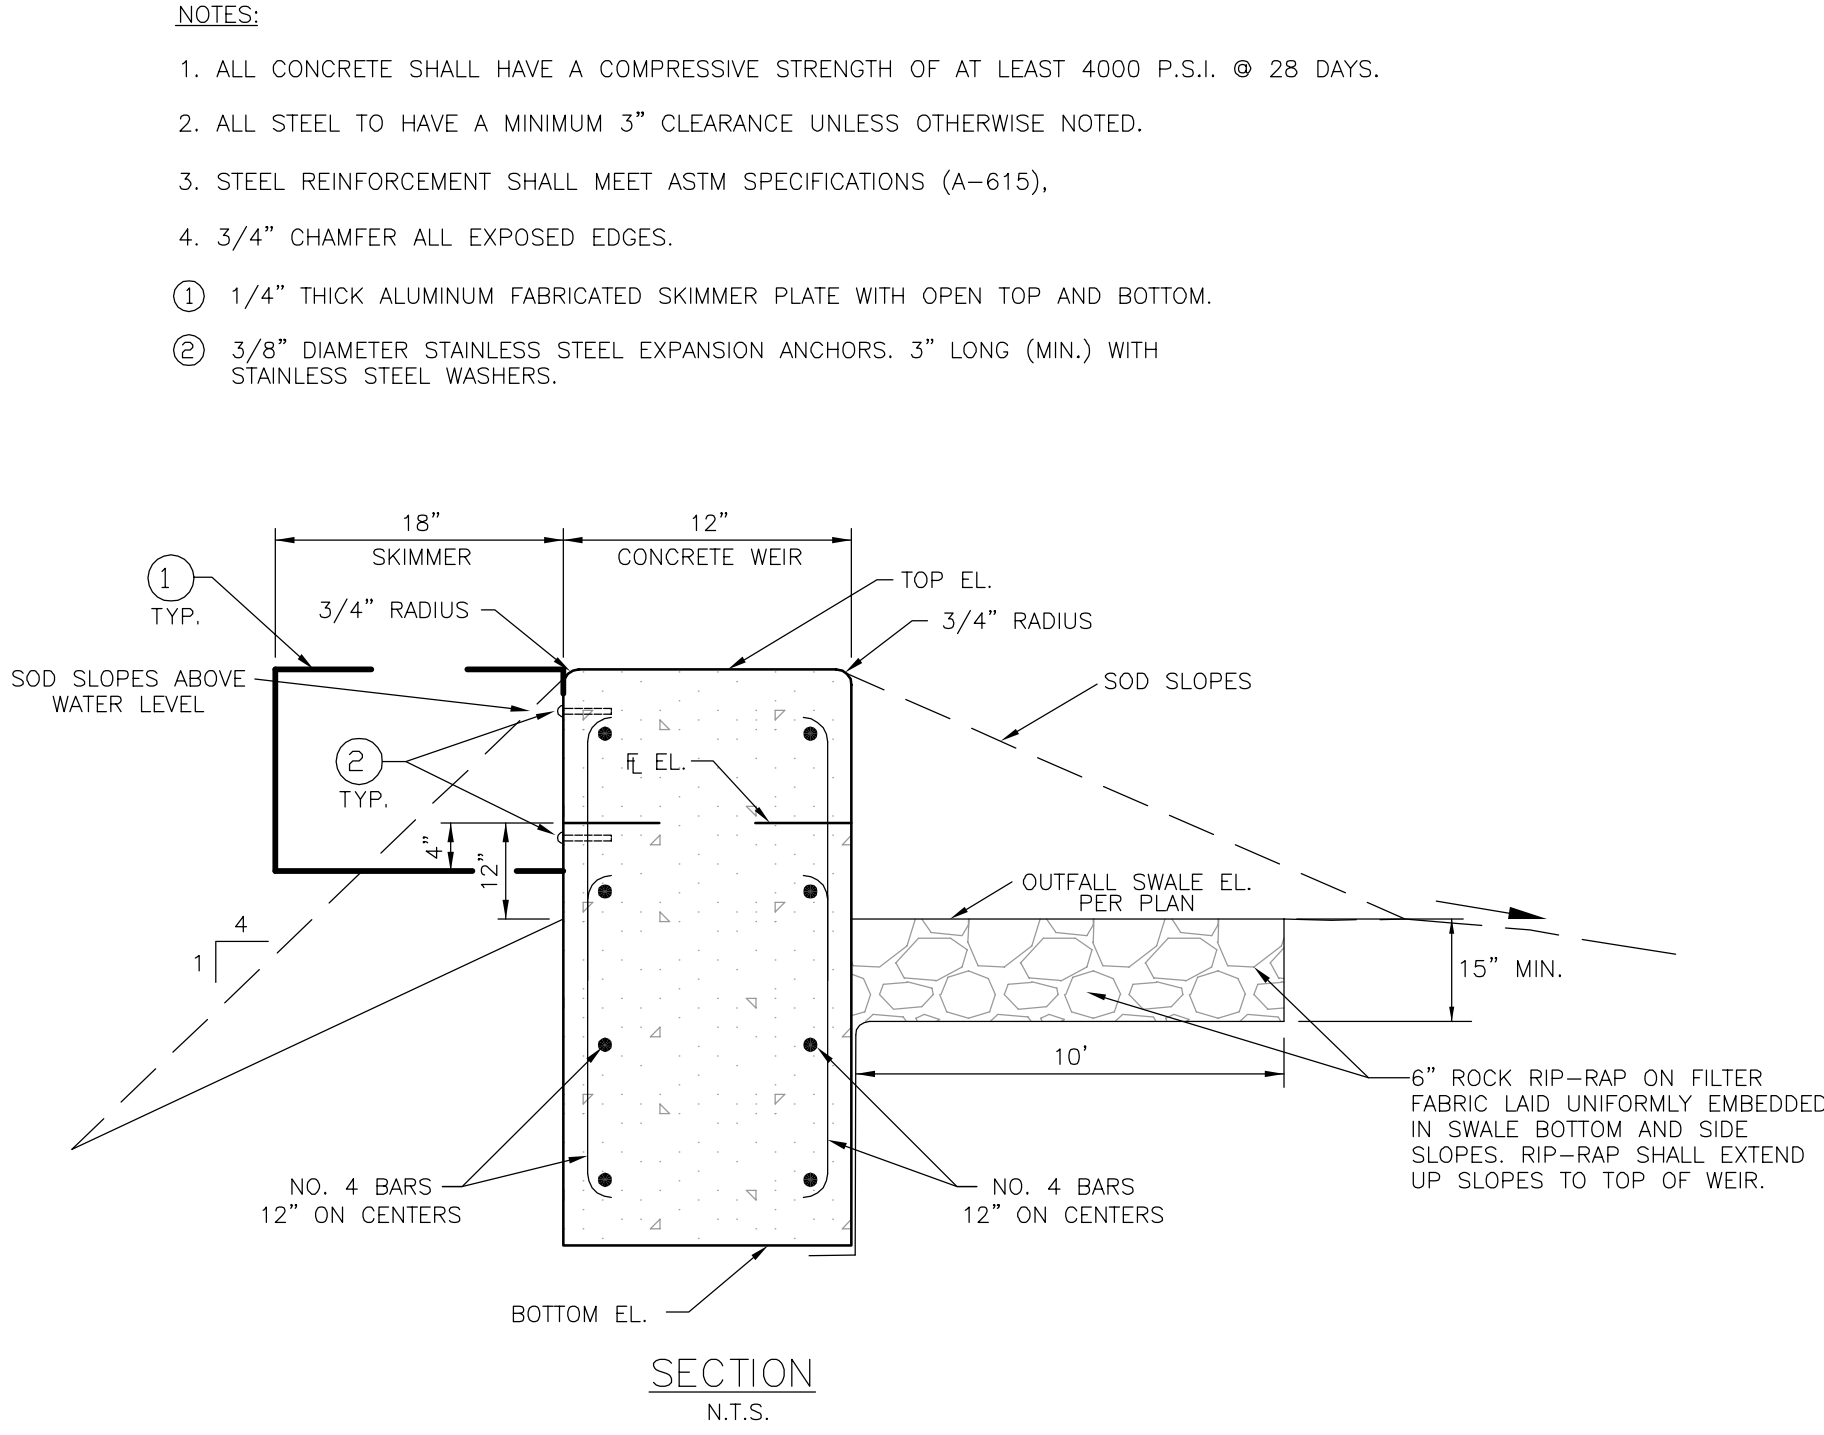


CONCRETE WEIR DETAIL
N.T.S.

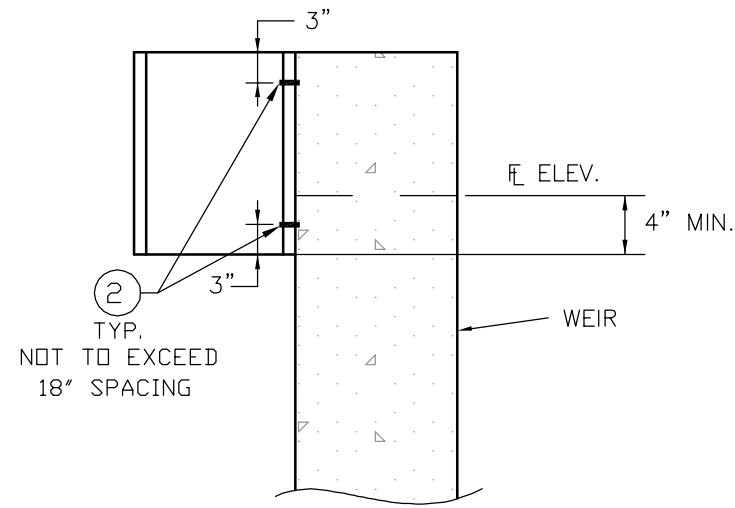


SKIMMER PLATE DETAIL
SIDE VIEW
N.T.S.

- NOTES:**
- OUTFALL SWALE BOTTOM SHALL BE 4' WIDE WITH 3:1 SIDE SLOPES THROUGH BUFFER AND 2:1 SIDE SLOPES IN WETLAND.
 - PLANT SWALE BOTTOM WITH SPARTINA BAKERI ON 2' CENTERS (INCLUDES SWALE SLOPES IN WETLAND AREA AND SWALE SLOPES BELOW WATER LEVEL).
 - SOD UPLAND AND BUFFER SWALE SLOPES.

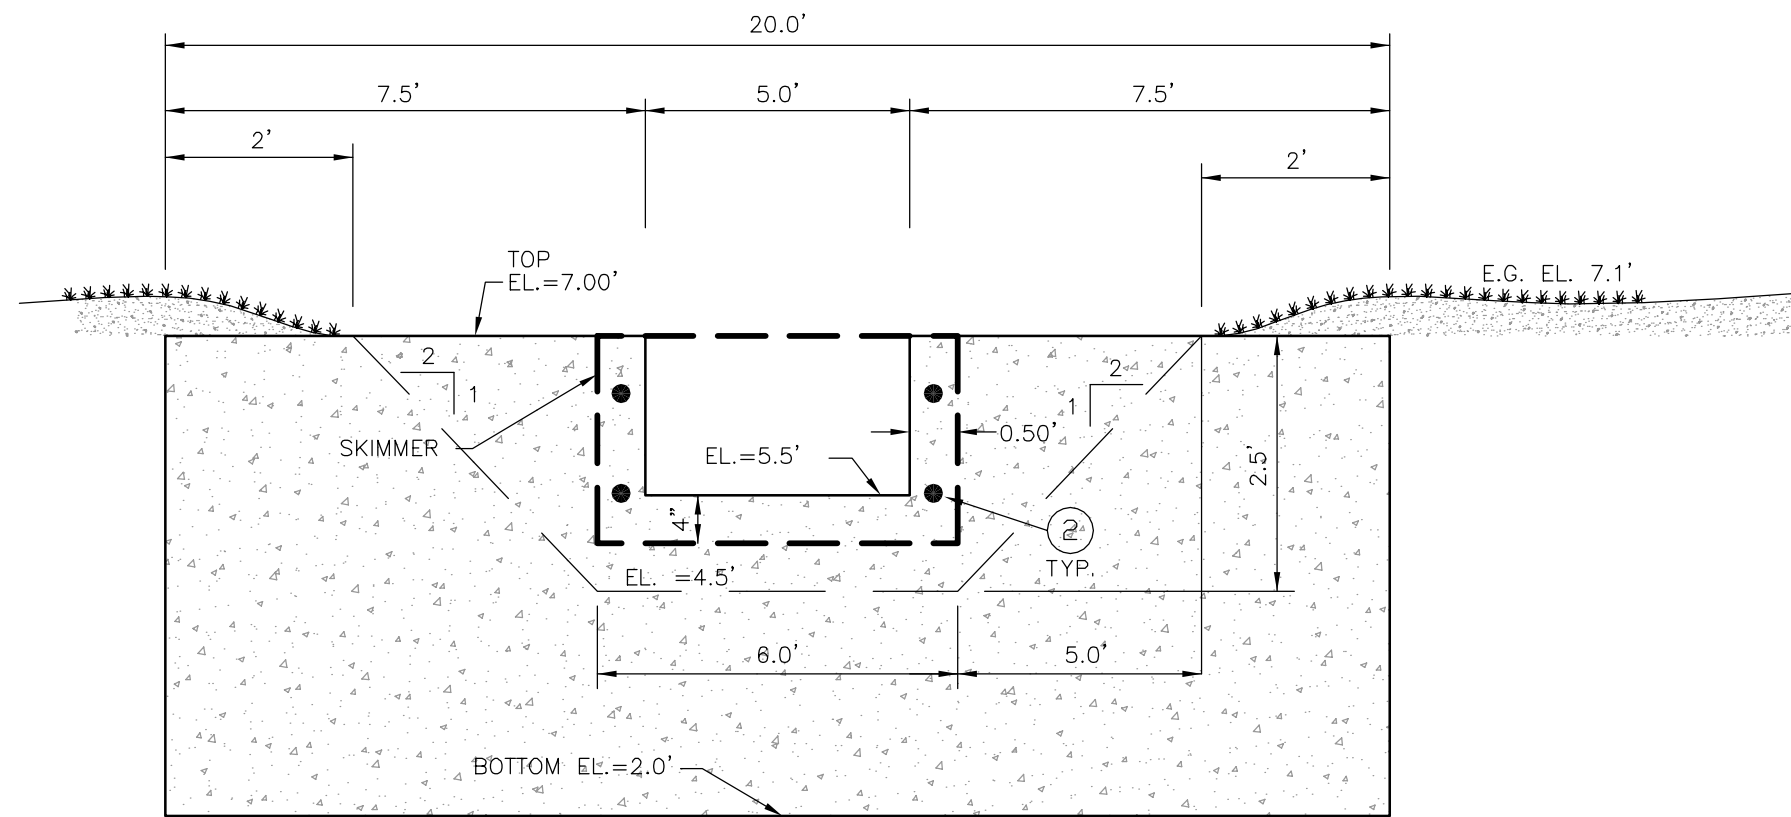



CONTROL STRUCTURE FOR POND #29 OUTFALL
N.T.S.

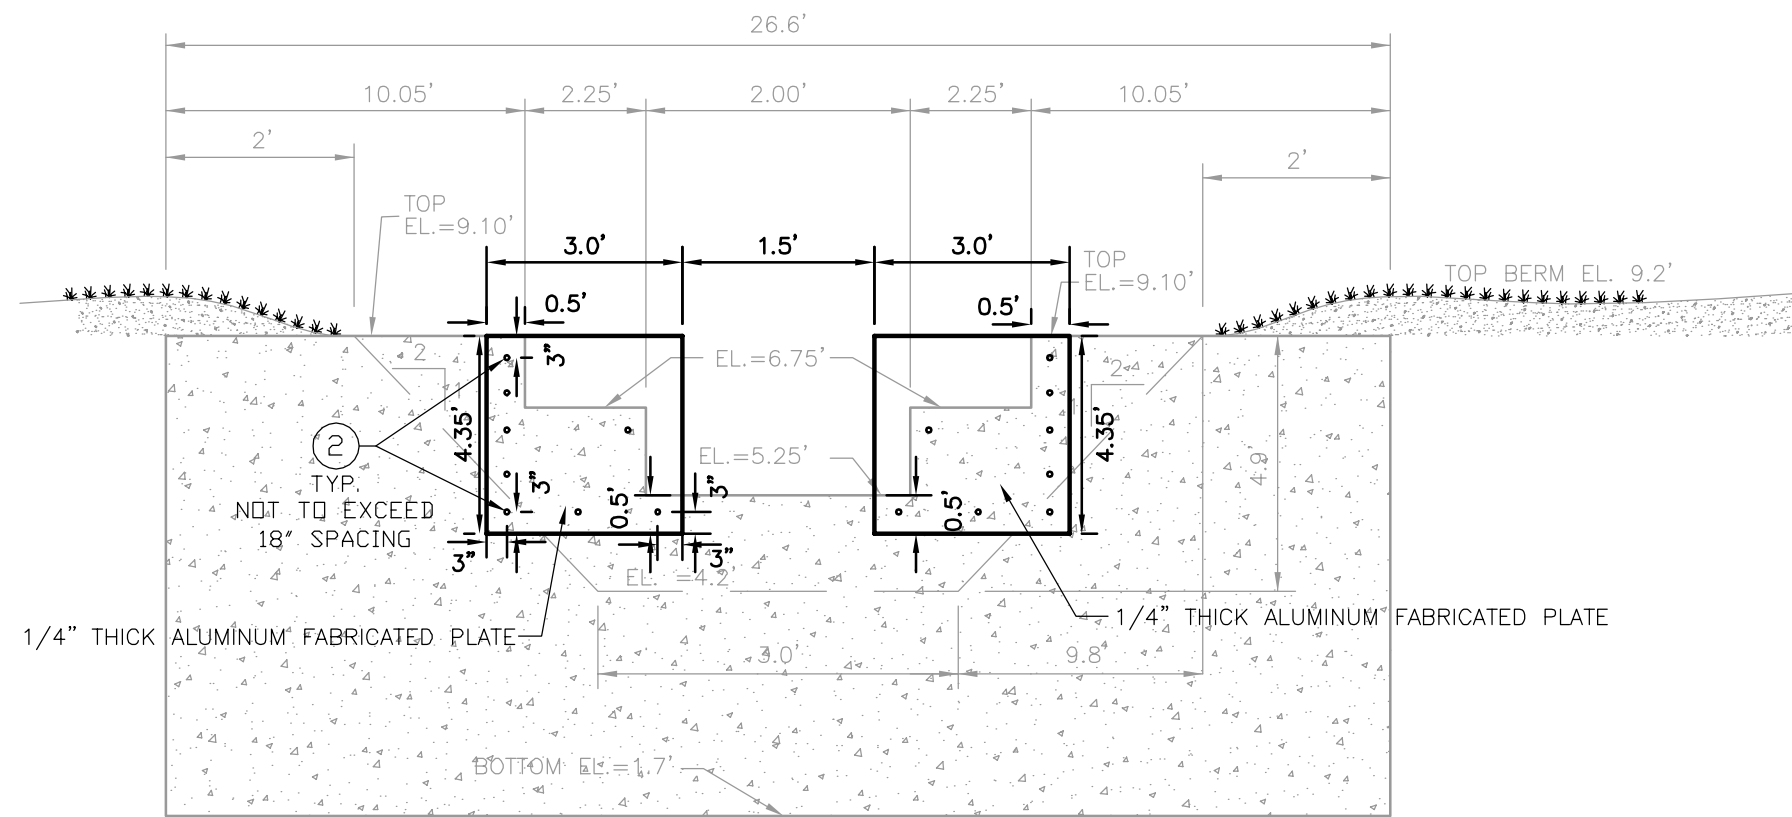

MODIFICATION TO EXISTING CONTROL STRUCTURE FOR WETLAND "P" OUTFALL
WEIR ORIGINALLY CONSTRUCTED WITH PHASE 1C(b)
N.T.S.

NOTE: PLAN, SECTIONS
AND DETAILS SHOWN ARE
NOT TO ANY SCALE.

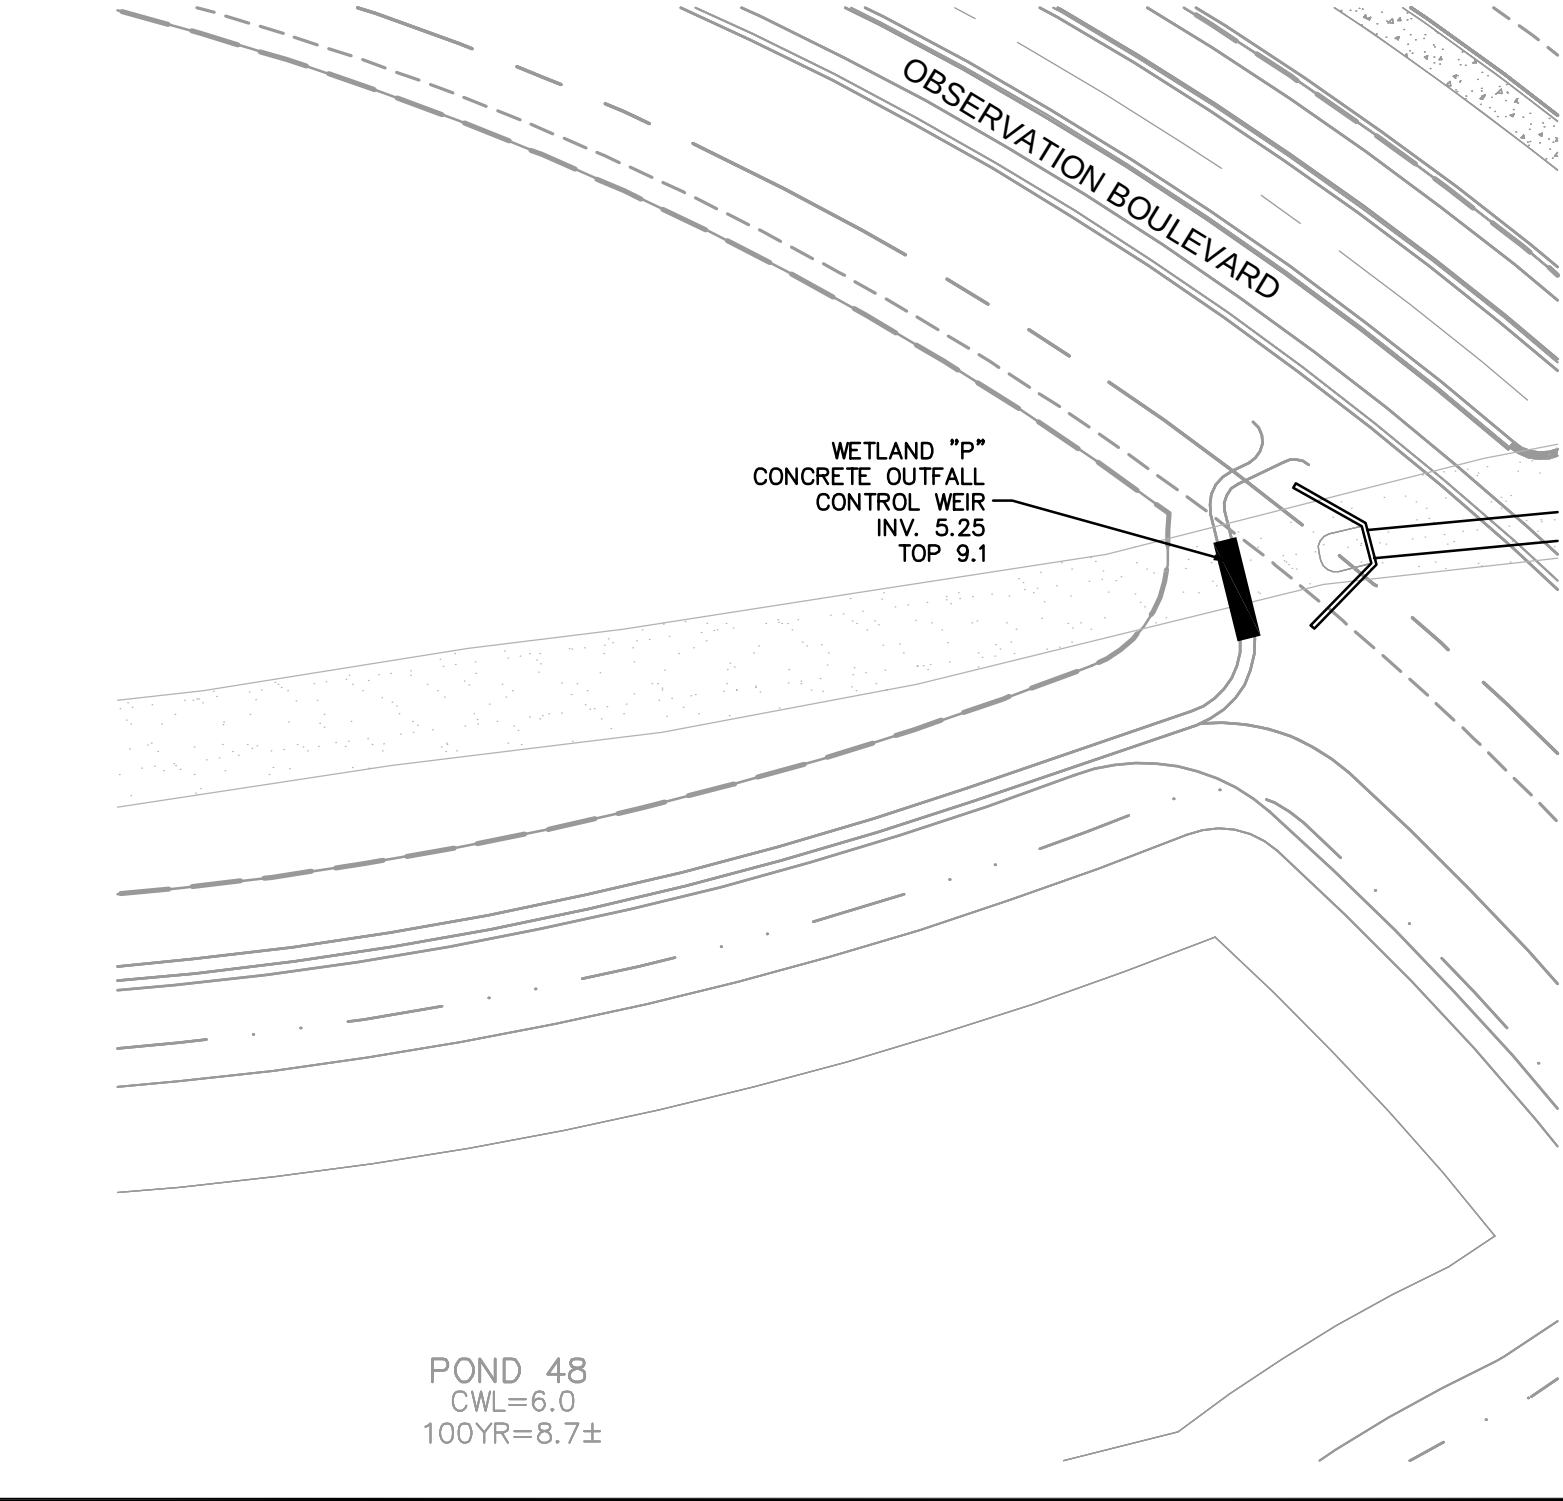

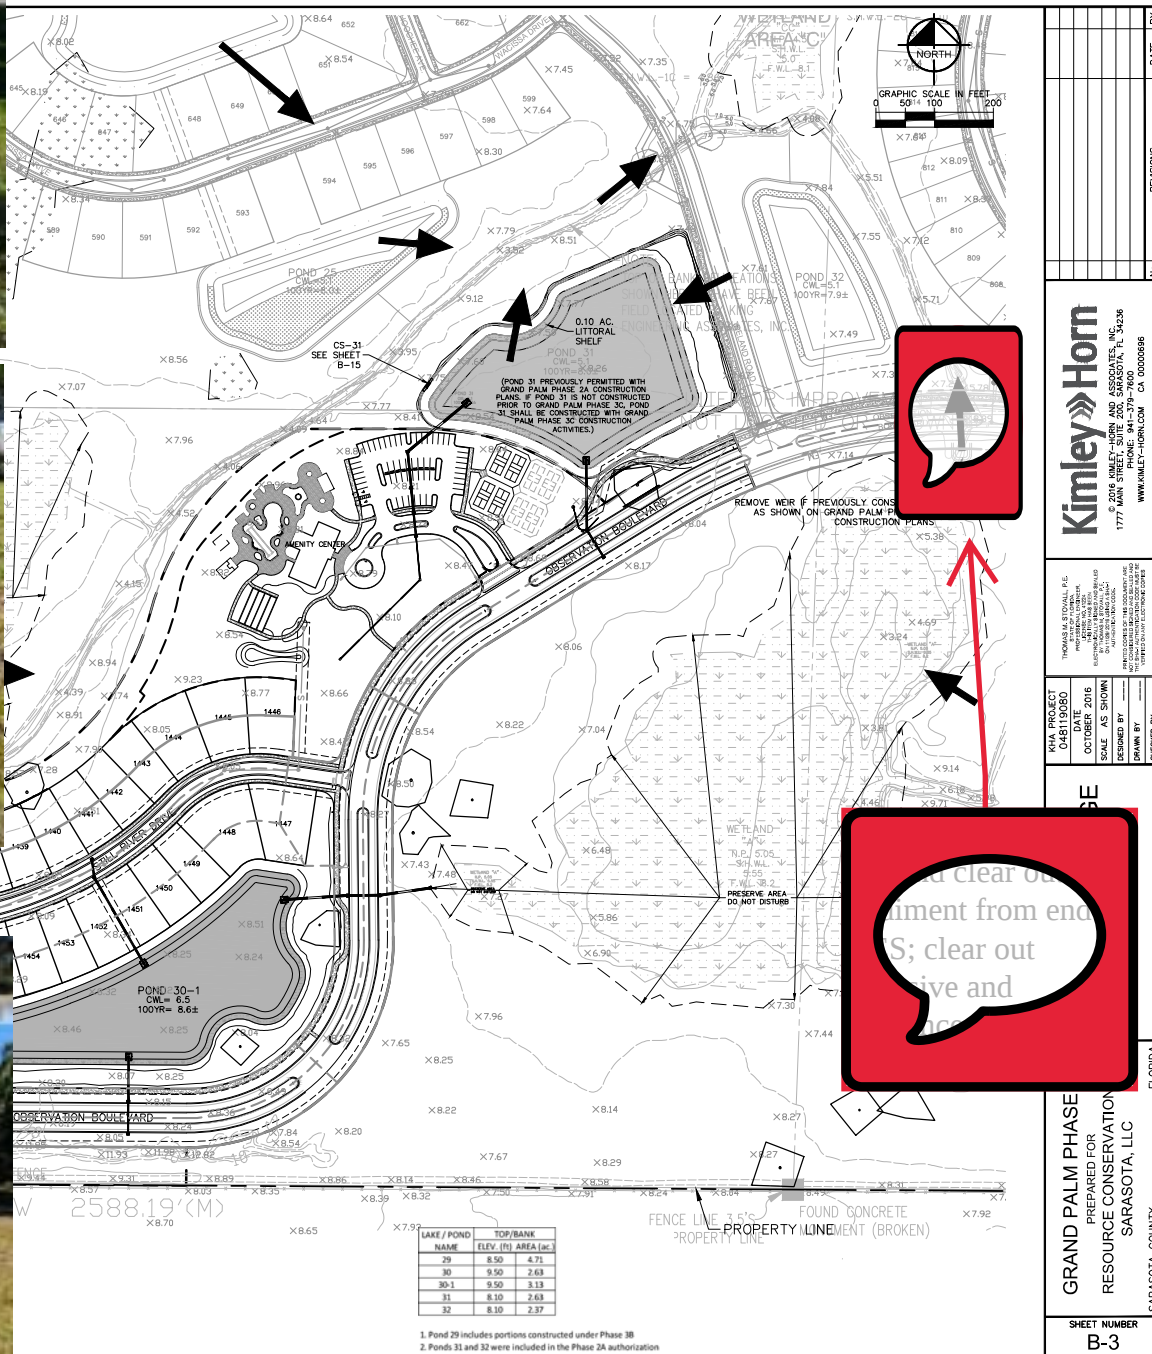

Kimley»Horn

5 DEAN BLVD., SUITE 200, SARASOTA, FL 34236
PHONE: 941-239-7600
WWW.KIMLEY-HORN.COM

THOMAS A. HORN, P.E.
KIMLEY-HORN, INC.
SARASOTA, FLORIDA
KIMLEY-HORN, INC. IS AN EQUAL OPPORTUNITY EMPLOYER
KIMLEY-HORN, INC. IS AN EQUAL OPPORTUNITY EMPLOYER
KIMLEY-HORN, INC. IS AN EQUAL OPPORTUNITY EMPLOYER

KHA PROJECT
CHITTSBO
OCTOBER 2016
SCALE AS SHOWN
DESIGNED BY
DRAWN BY
CHECKED BY



SE

GRAND PALM PHASE
PREPARED FOR
RESOURCE CONSERVATION
SARASOTA, LLC

SARASOTA COUNTY
FLORIDA

SHEET NUMBER
B-3


NO. REVISIONS DATE BY

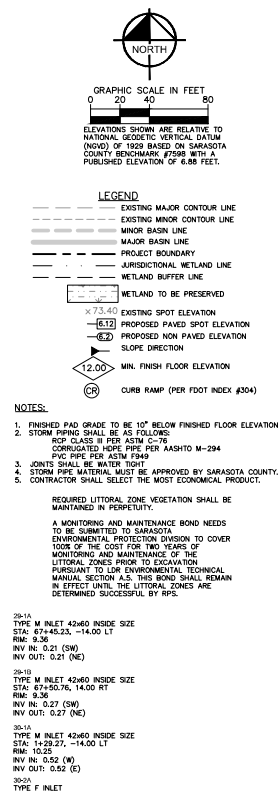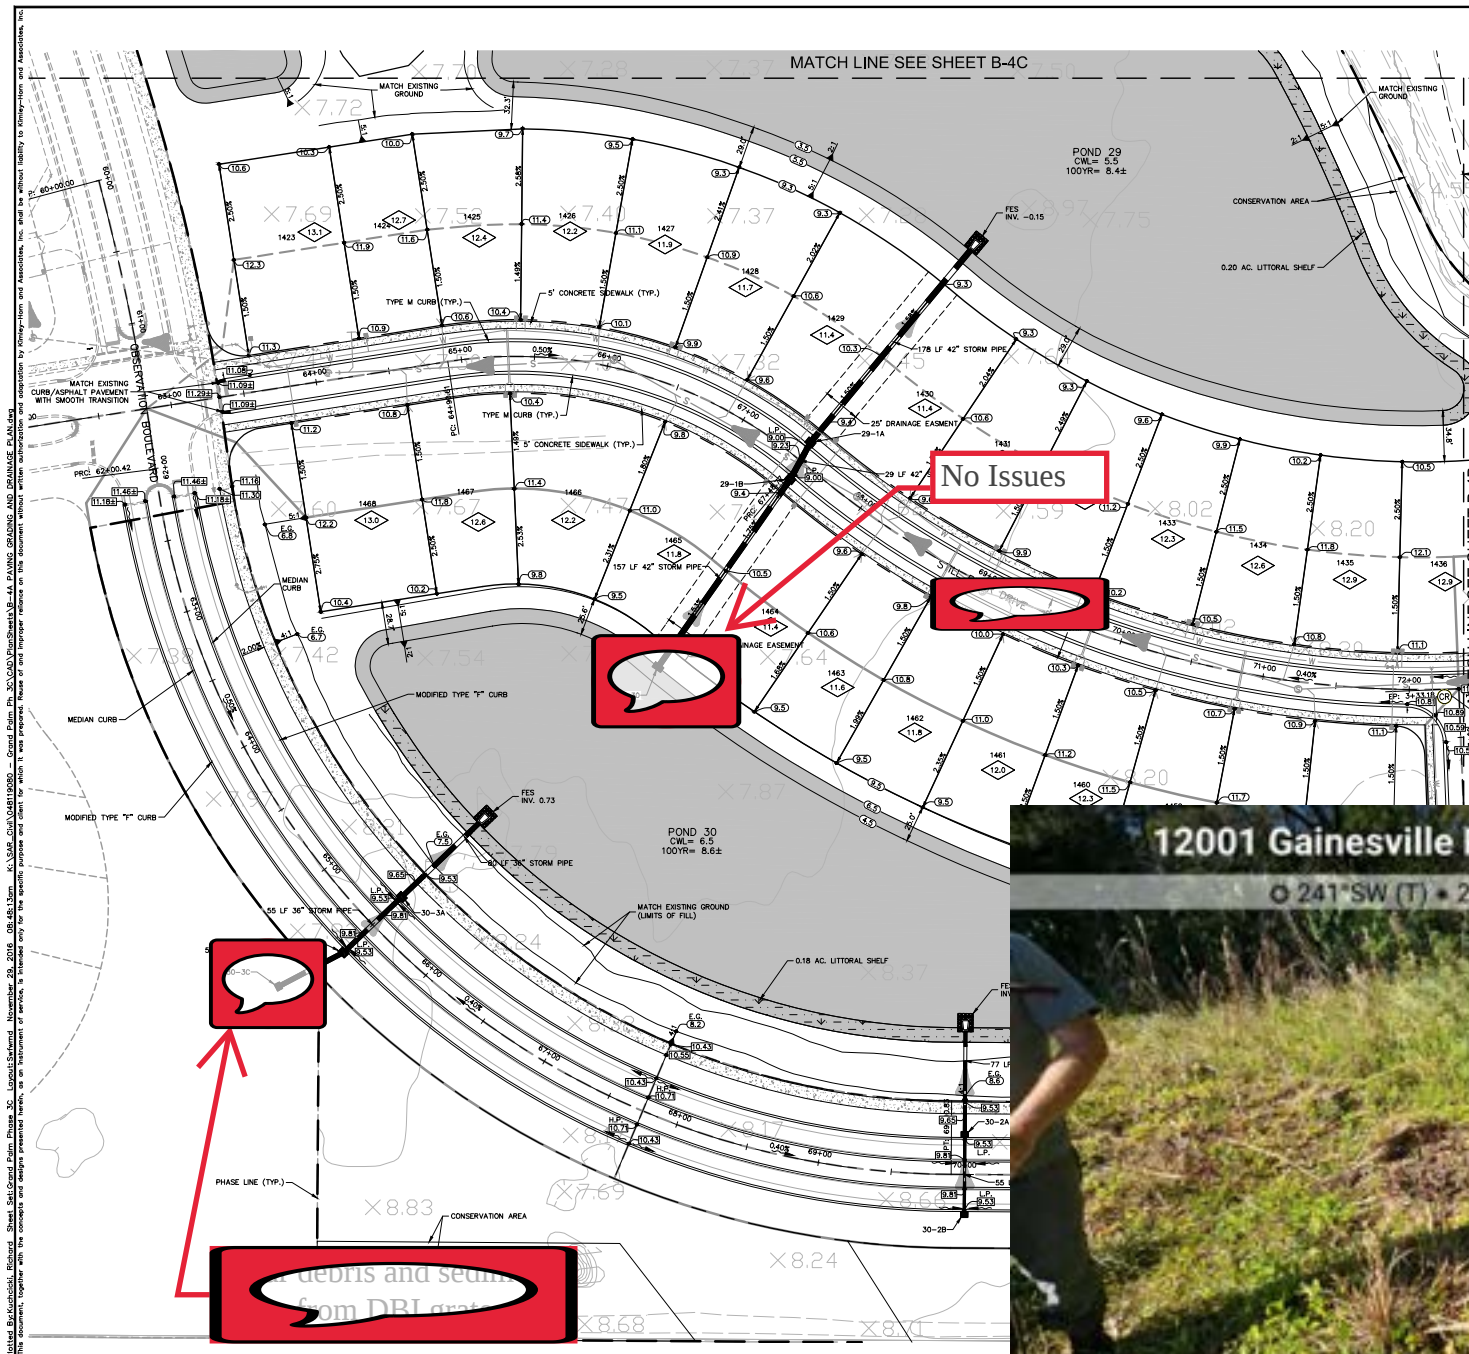

KIMLEY-HORN 1777 MAIN STREET, SUITE 200 SAN ANTONIO, TEXAS 78205 PHONE: 847-378-7600 WWW.KIMLEY-HORN.COM CA 00000966	THOMAS & GATWALL, P.L.L.C. 10000 N. FARM ROAD, SUITE 100 FARMERS BRANCH, TEXAS 76044 817-291-1100 10000 N. FARM ROAD, SUITE 100 FARMERS BRANCH, TEXAS 76044 817-291-1100	NHA PROJECT 045110080 OCTOBER 2016 SCALE AS SHOWN DESIGNED BY DRAWN BY CHECKED BY	No. REVISIONS DATE BY




PROPOSED PAVING GRADING AND DRAINAGE PLAN FOR THE CONSERVATION AREA OF GRAND PALM PHASE 3C, SARASOTA COUNTY, FLORIDA

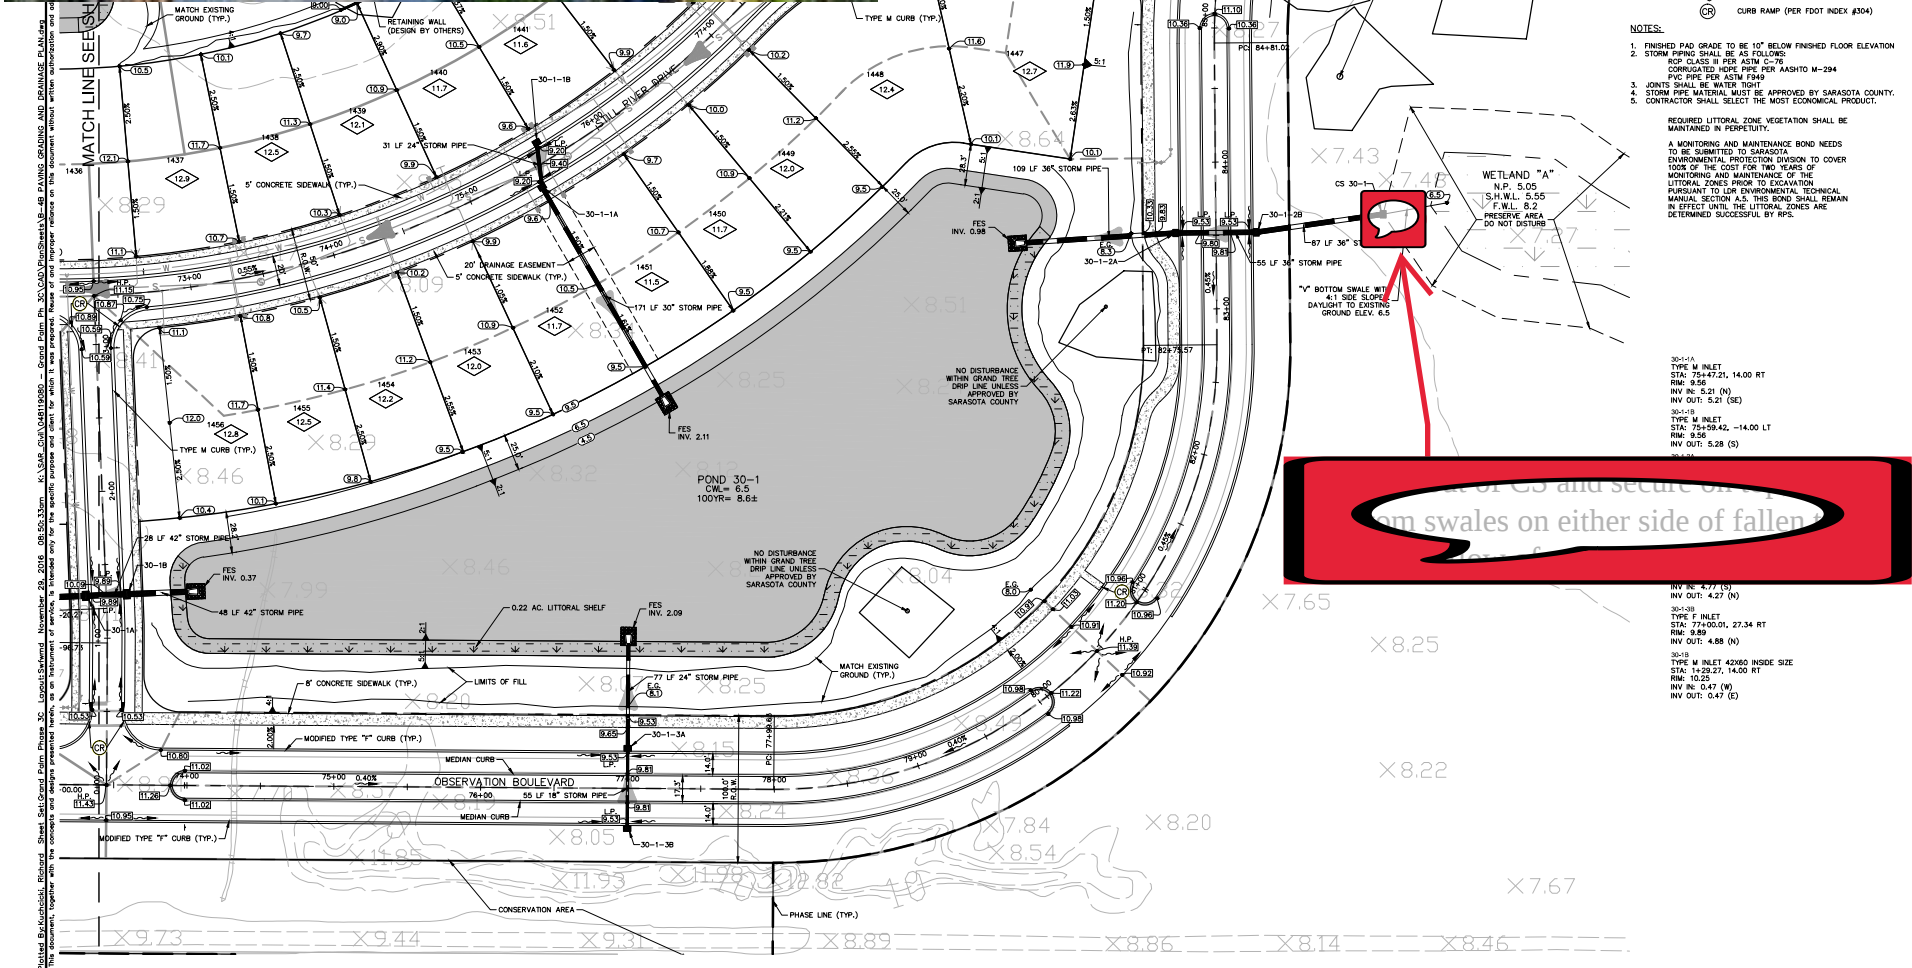

- NOTES:
1. FINISHED PAD GRADE TO BE 10" BELOW FINISHED FLOOR ELEVATION
 2. STORM PIPING SHALL BE AS FOLLOWS:
RCP CLASS II PER ASTM C-76
CORROGATED HDPE PIPE PER AASHTO M-294
PVC PIPE PER ASTM F849
 3. JOINTS SHALL BE WATER TIGHT
 4. STORM PIPE MATERIAL MUST BE APPROVED BY SARASOTA COUNTY.
 5. CONTRACTOR SHALL SELECT THE MOST ECONOMIC PRODUCT.
- REQUIRED LITTORAL ZONE VEGETATION SHALL BE MAINTAINED IN PERPETUITY.
- A MONITORING AND MAINTENANCE BOND NEEDS TO BE SUBMITTED TO SARASOTA ENVIRONMENTAL PROTECTION DIVISION TO COVER COST OF THE BOND FOR TWO YEARS OF MONITORING AND MAINTENANCE OF THE LITTORAL ZONE PRIOR TO EXCAVATION PURSUANT TO LOP ENVIRONMENTAL TECHNICAL MANUAL SECTION 4.5. THIS BOND SHALL REMAIN IN EFFECT UNTIL THE LITTORAL ZONES ARE DETERMINED SUCCESSFUL BY RPS.

KIMLEY-HORN INC. 1777 MAIN STREET, SUITE 200, SARASOTA, FL 34236 PHONE: 941-579-7600 WWW.KIMLEY-HORN.COM	PROJECT CHETTER OCTOBER 2016 SCALE AS SHOWN DESIGNED BY DRAWN BY CHECKED BY	PAVING GRADING AND DRAINAGE PLAN	GRAND PALM PHASE 3C PREPARED FOR RESOURCE CONSERVATION OF SARASOTA, LLC FLORIDA SARASOTA COUNTY	SHEET NUMBER B-4B	NO.	REVISIONS	DATE

PERMITTED TO CONVEY INFORMATION TO ANY OTHER PARTY WITHOUT THE WRITTEN AUTHORIZATION OF THE ENGINEER. THE ENGINEER'S LIABILITY IS LIMITED TO THE DESIGN OF THE PROJECT ONLY.

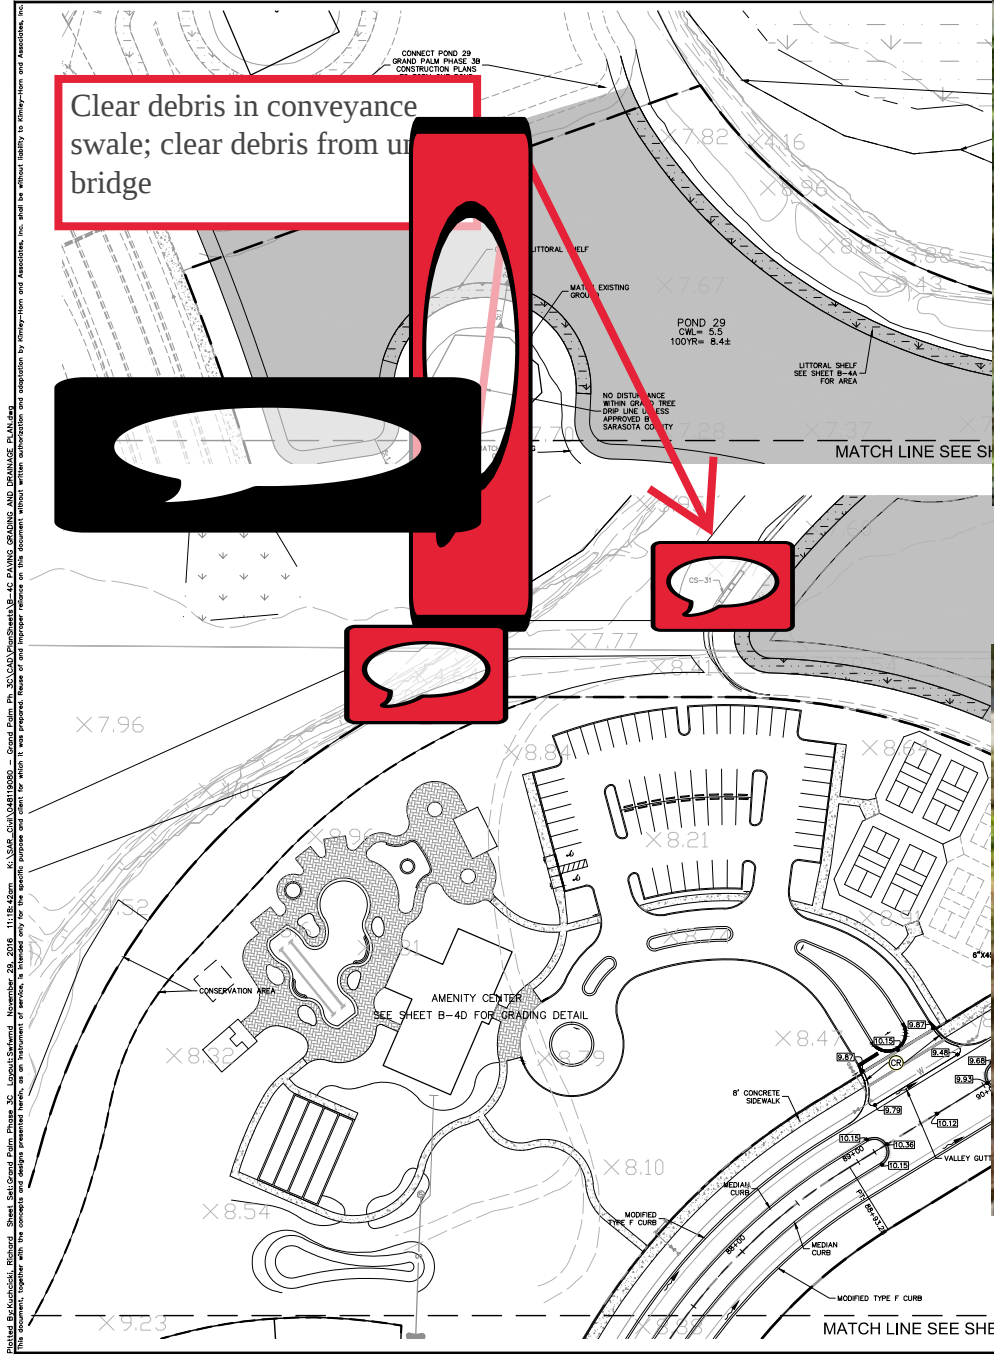

MAINTAINED IN PERPETUITY.

A MONITORING AND MAINTENANCE BOND NEEDS TO BE SUBMITTED TO SARASOTA ENVIRONMENTAL PROTECTION DIVISION TO COVER 100% OF THE COST FOR TWO YEARS OF MONITORING AND MAINTENANCE OF THE LITTORAL ZONES PRIOR TO EXCAVATION PURSUANT TO LOP ENVIRONMENTAL TECHNICAL MANUAL SECTION A.5. THIS BOND SHALL REMAIN IN EFFECT UNTIL THE LITTORAL ZONES ARE DETERMINED SUCCESSFUL BY RPS.

(POND 31 PREVIOUSLY PERMITTED WITH GRAND PALM PHASE 2A CONSTRUCTION PLANS. IF POND 31 IS NOT CONSTRUCTED PRIOR TO GRAND PALM PHASE 3C, POND 31 SHALL BE CONSTRUCTED WITH GRAND PALM PHASE 3C CONSTRUCTION ACTIVITIES.)



GRAND RESOURCE SA SARASOTA COUNTY

SHEET NUMBER B-4C

